

FALL CREEK REGIONAL WASTE DISTRICT

No 6225

9378 S 650 WEST, P.O. BOX 59, PENDLETON, IN 46064

765-778-7544

AGREEMENT FOR SANITARY SEWER SERVICE

22-50565.00

This Agreement made and entered into this 15 day of May, 2007, between FALL CREEK REGIONAL WASTE DISTRICT ("District") and David Bash (Paul) ("Applicant") regarding the provision of sanitary sewer service, and the assignment of capacity in, and connection to, the District's facilities for the premises located at 7447 S 25 E

NOW THEREFORE, the parties, in consideration of the mutual promises set out in this Agreement, the receipt and sufficiency of which is hereby acknowledged, agree as follows:

1. The Applicant agrees that all workmanship and materials shall conform to all District ordinances and the District's construction standards. District must accept and approve all work and materials before backfilling and final connection is made to the sewer mains. Any violation of this provision will cause all lines and appurtenances in violation to be removed and replaced at the Applicant's expense.
2. The District shall have the right to enter upon the Applicant's premises at all reasonable times to inspect, repair, or replace any equipment used in connection with the District's service or which has an impact on said service.
3. The Applicant shall be responsible for all monthly user rates, capacity charges, and tap fees. The failure to pay any rate charge or fee may result in a lien against the property and/or the termination of service to the property, the cost of which will be borne by Applicant, including, but not limited to, all attorney's fees and collection costs.
4. The District shall not be responsible for any damages as a result of any failure to supply service unless said damages are due to default, neglect or culpability on the part of the District.
5. If there is an available sanitary sewer within three hundred (300) feet of the property line, the property owner shall be required to connect to the District's sanitary sewer system.
6. The Applicant and District agree that the provision of sanitary sewer service touches and concerns the property and the terms of this Agreement bind the District and Applicant and their heirs, executors, administrators, personal representatives, successors, agents, attorneys, assigns, designees, and transferees.

The parties hereto have read and fully understand the above provisions and agree to comply with said provisions.

FALL CREEK REGIONAL WASTE DISTRICT
Rebecca Hunter
Signature

APPLICANT
Paul M. Bash
Signature

STATE OF INDIANA)
) SS:
COUNTY OF MADISON)

SUBSCRIBED and sworn to before me this 15th day of May, 2007.

My Commission Expires:
4-19-2008


Signature Teresa K. Hutton
Printed Teresa K. Hutton
Notary Public
Resident of Madison County

INSPECTOR SN DATE INSPECTED 5/24/07 APPROVED ✓ REJECTED _____

REASON FOR REJECTION _____

DATE REINSPECTED _____ APPROVED _____ REJECTED _____

NOTES:
SIZE PIPE 4"/1 1/2" TYPE PIPE 35/160 PSI
BASEMENT YES NO
SUMP PUMP YES NO
DOWNSPOUT TO GROUND YES NO
SEPTIC TANK PUMPED & FILLED YES Hydens NO
CONTRACTOR Koffen
SPECIAL CONDITIONS _____
EXISTING HOME ✓
NEW CONSTRUCTION _____

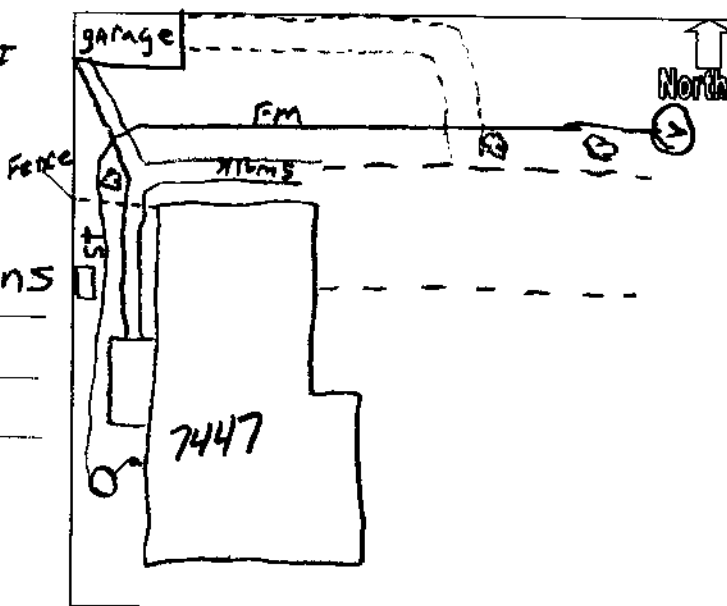



DAVID OR BELLA BASH
PH 765-778-2210
7447 S COUNTY RD 25 EAST
PENDLETON, IN 46064

5154
71-187749
BRIANSON 104

5-15-07

DATE

PAY TO THE
ORDER OF

FCRWD

\$ 2001.51

Two thousand one and 51/100

DOLLARS



Security
Features
Details on
Back



FOR

Tap Fee, Grinder + Service

Monthly

Bill M. Bash

⑆074901672⑆

328