

Gidw.

PROJECT Phase II SHEET _____ OF _____


SUBJECT _____ DATE 6-20-18

JOB NO. 4447

BY Atlas

747 S. Pendleton

← N

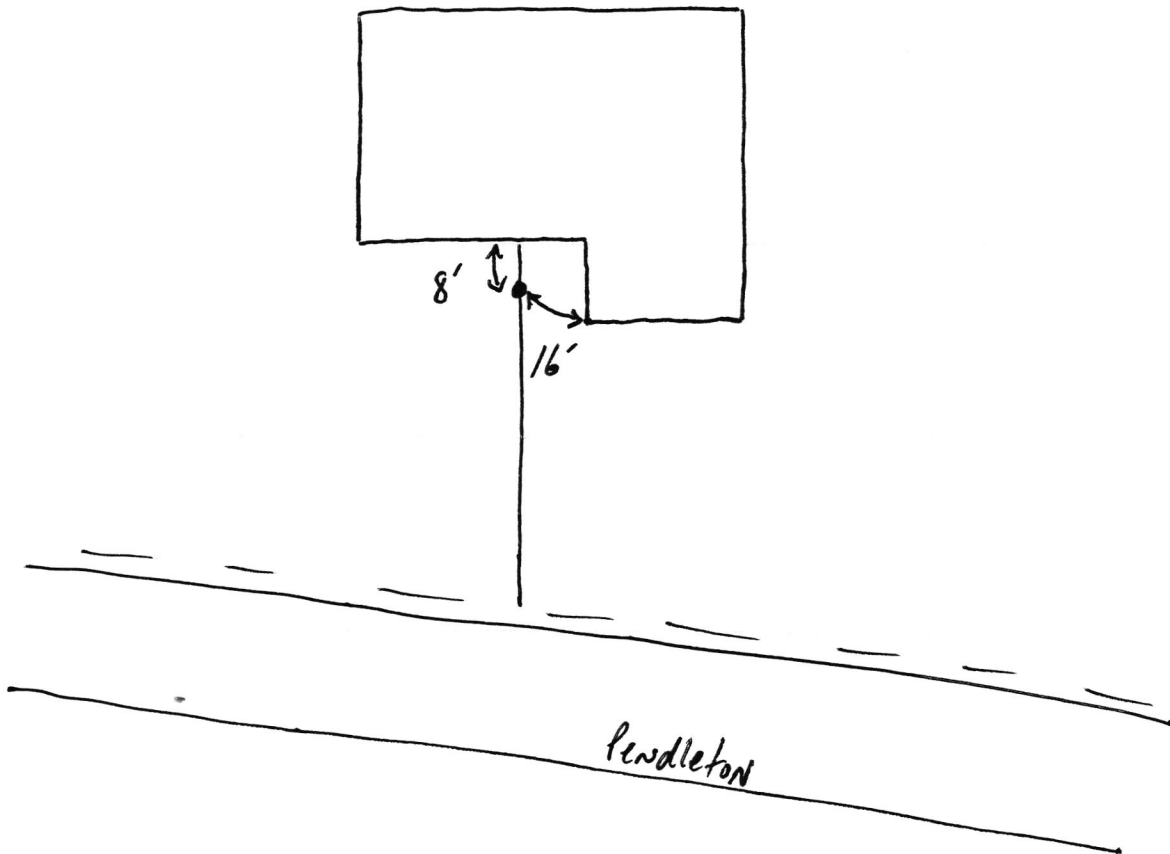

747 S Pendleton
SPE Phase II

6.25.18

