

Gidw.

PROJECT Phase II SHEET _____ OF _____


SUBJECT _____ DATE 6-19-18

JOB NO. 4447

BY Atlas

748 S. Center

N →

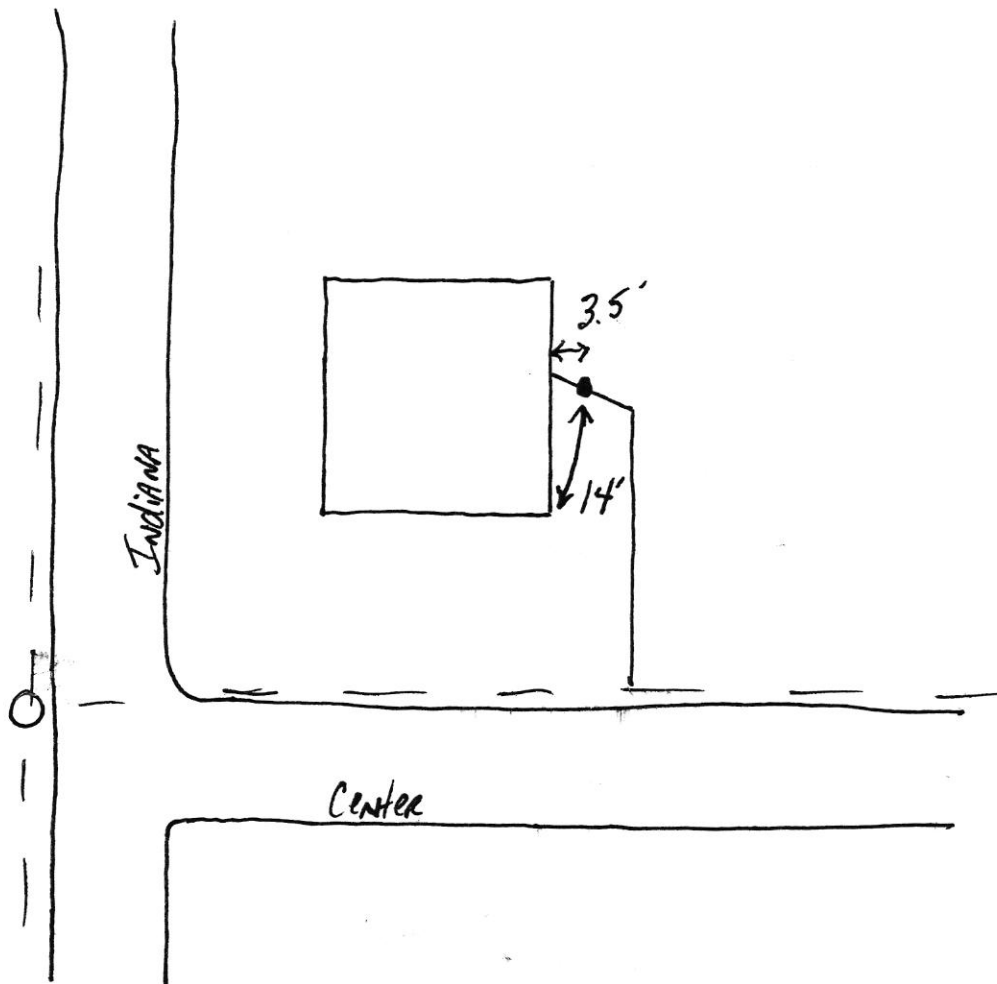

110 center

SPT phase II

6-21-18

