

Gidw.


PROJECT Phase II SHEET _____ OF _____

SUBJECT _____ DATE 5-9-18

JOB NO. 4447

BY Atlas

748 S. BROADWAY

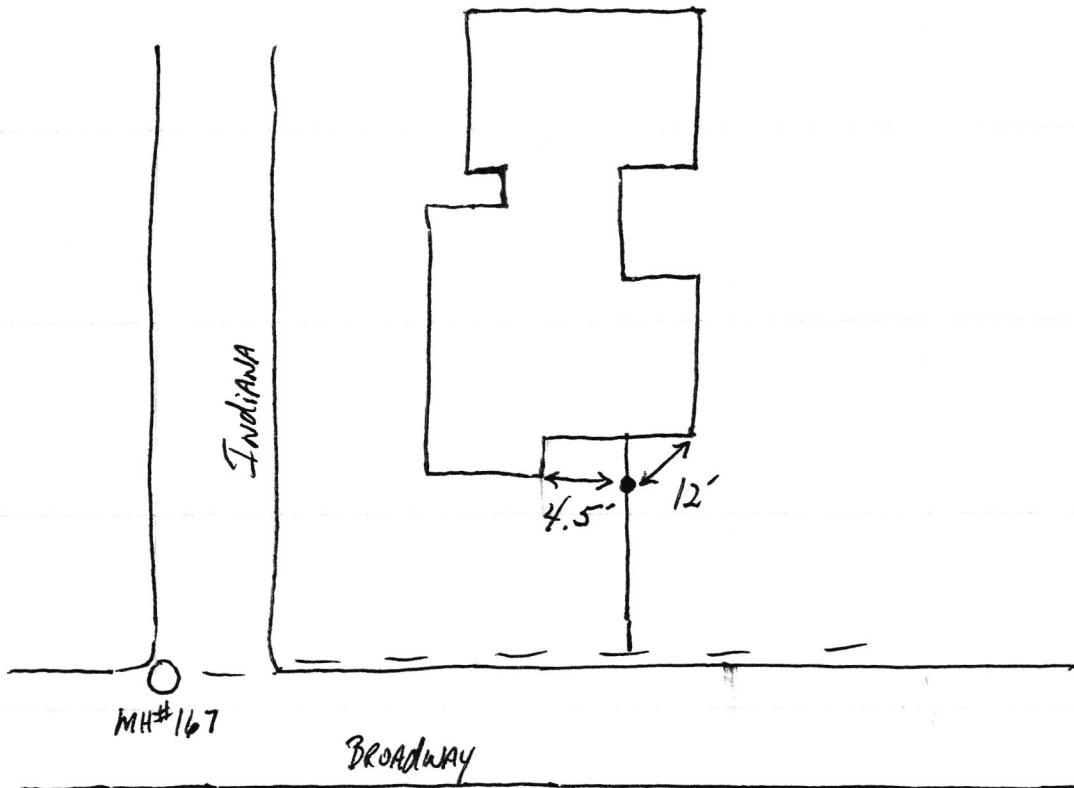

748 S Broadway

SIF Phase II

5.14.18

