

22-50500.00
4605

FALL CREEK REGIONAL WASTE DISTRICT

9378 S 650 WEST, P.O. BOX 59, PENDLETON, IN 46064

765-778-7544

AGREEMENT FOR SANITARY SEWER SERVICE

This Agreement made and entered into this 11th day of July, 2002 between FALL CREEK REGIONAL WASTE DISTRICT ("District") and TIM Beck ("Applicant") regarding the provision of sanitary sewer service, and the assignment of capacity in, and connection to, the District's facilities for the premises located at 7522 S 25 E. Saddlebrook Estates

NOW THEREFORE, the parties, in consideration of the mutual promises set out in this Agreement, the receipt and sufficiency of which is hereby acknowledged, agree as follows:

1. The Applicant agrees that all workmanship and materials shall conform to all District ordinances and the District's construction standards. District must accept and approve all work and materials before backfilling and final connection is made to the sewer mains. Any violation of this provision will cause all lines and appurtenances in violation to be removed and replaced at the Applicant's expense.
2. The District shall have the right to enter upon the Applicant's premises at all reasonable times to inspect, repair, or replace any equipment used in connection with the District's service or which has an impact on said service.
3. The Applicant shall be responsible for all monthly user rates, capacity charges, and tap fees. The failure to pay any rate charge or fee may result in a lien against the property and/or the termination of service to the property, the cost of which will be borne by Applicant, including, but not limited to, all attorney's fees and collection costs.
4. The District shall not be responsible for any damages as a result of any failure to supply service unless said damages are due to default, neglect or culpability on the part of the District.
5. If there is an available sanitary sewer within three hundred (300) feet of the property line, the property owner shall be required to connect to the District's sanitary sewer system.
6. The Applicant and District agree that the provision of sanitary sewer service touches and concerns the property and the terms of this Agreement bind the District and Applicant and their heirs, executors, administrators, personal representatives, successors, agents, attorneys, assigns, designees, and transferees.

The parties hereto have read and fully understand the above provisions and agree to comply with said provisions.

FALL CREEK REGIONAL WASTE DISTRICT

Signature Jan Carey

APPLICANT

Signature Robert [Signature]

STATE OF INDIANA)
) SS:
COUNTY OF MADISON)

SUBSCRIBED and sworn to before me this 15th day of July, 2002.

My Commission Expires:

4-29-09

Signature Jan E. Carey

Printed Jan E. Carey

Notary Public

Resident of Madison County

INSPECTOR Ben DATE INSPECTED 7-15-02 APPROVED ✓ REJECTED _____

REASON FOR REJECTION _____

DATE REINSPECTED _____ APPROVED _____ REJECTED _____

NOTES: 4" 1 1/2" TYPE PIPE PUC

BASEMENT YES _____ NO X

SUMP PUMP YES _____ NO X

DOWNSPOUT TO GROUND YES X NO _____


SEPTIC TANK PUMPED & FILLED YES _____ NO X

CONTRACTOR Hought Koffler

SPECIAL CONDITIONS _____

EXISTING HOME _____

NEW CONSTRUCTION K

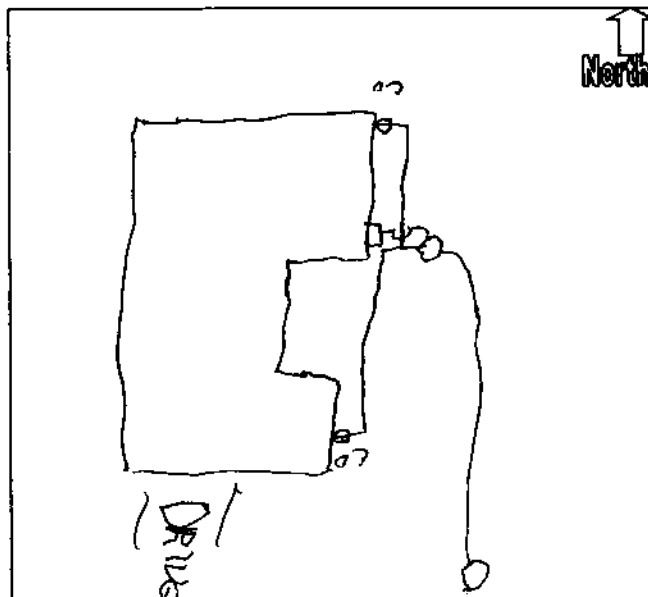

LONG & KOFFER, INC.
1795 W. HUNTSVILLE RD.
PENDLETON, INDIANA 46064
765/778-5219

NATIONAL CITY BANK OF INDIANA
INDIANAPOLIS, INDIANA 46255
20-6/740

1664

PAY TO THE
ORDER OF

FCRWD

One thousand twenty-four and 80/100

\$ 1024.80

DOLLARS

MEMO:

John R. Long

⑈001664⑈ ⑆074000065⑆

SECURITY FEATURES: MICRO PRINT TOP & BOTTOM BORDERS - COLORED PATTERN - ARTIFICIAL WATERMARK ON REVERSE SIDE - MISSING FEATURE INDICATES A COPY


RIFFEY BUILDERS INC.
5205 S. 525W
PENDLETON, IN 46064-9174

71-553/749
7903383

910

DATE 7-15-02

PAY TO THE ORDER OF Fall Creek Regional Waste \$ 2635

Two Thousand Six Hundred Thirty Five ⁰⁰/₁₀₀ DOLLARS 



Madison
Community Bank

MEMO Beck Job

Robert Riff

⑆074905539⑆

0910

SAFE TO REUSE