

№ 5663

765-778-7544

This Agreement made and entered into this 12 day of August, 2005, between FALL CREEK REGIONAL WASTE DISTRICT ("District") and CP Morgan ("Applicant") regarding the provision of sanitary sewer service, and the assignment of capacity in, and connection to, the District's facilities for the premises located at PH Lot 35

NOW THEREFORE, the parties, in consideration of the mutual promises set out in this Agreement, the receipt and sufficiency of which is hereby acknowledged, agree as follows:

1. The Applicant agrees that all workmanship and materials shall conform to all District ordinances and the District's construction standards. District must accept and approve all work and materials before backfilling and final connection is made to the sewer mains. Any violation of this provision will cause all lines and appurtenances in violation to be removed and replaced at the Applicant's expense.
2. The District shall have the right to enter upon the Applicant's premises at all reasonable times to inspect, repair, or replace any equipment used in connection with the District's service or which has an impact on said service.
3. The Applicant shall be responsible for all monthly user rates, capacity charges, and tap fees. The failure to pay any rate charge or fee may result in a lien against the property and/or the termination of service to the property, the cost of which will be borne by Applicant, including, but not limited to, all attorney's fees and collection costs.
4. The District shall not be responsible for any damages as a result of any failure to supply service unless said damages are due to default, neglect or culpability on the part of the District.
5. If there is an available sanitary sewer within three hundred (300) feet of the property line, the property owner shall be required to connect to the District's sanitary sewer system.
6. The Applicant and District agree that the provision of sanitary sewer service touches and concerns the property and the terms of this Agreement bind the District and Applicant and their heirs, executors, administrators, personal representatives, successors, agents, attorneys, assigns, designees, and transferees.

The parties hereto have read and fully understand the above provisions and agree to comply with said provisions.

FALL CREEK REGIONAL WASTE DISTRICT
Jessie Sutton
Signature

APPLICANT
[Signature]
Signature

[illegible]

SUBSCRIBED and sworn to before me this 12 day of August, 2002.

My Commission Expires: 4-19-2008

Signature Meresa T. Salomon

Printed Teresa K. Hutton

Notary Public
Resident of Madison County

INSPECTOR 21 DATE INSPECTED 8-18-05 APPROVED ✓ REJECTED _____
REASON FOR REJECTION _____

DATE REINSPECTED APPROVED REJECTED

NOTES: SIZE PIPE 6" TYPE PIPE SDR35

BASEMENT YES NO X

SUMP PUMP YES NO ☒

DOWNSPOUT TO GROUND YES NO


SEPTIC TANK PUMPED & FILLED YES NO

CONTRACTOR Butz

SPECIAL CONDITIONS

EXISTING HOME

NEW CONSTRUCTION X

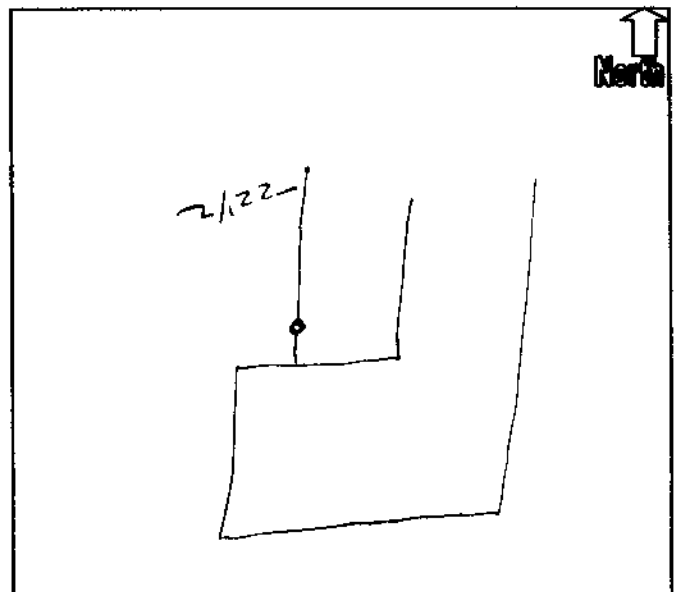

C.P. MORGAN COMMUNITIES, LP
CONSTRUCTION ACCOUNTBANK ONE, NA
INDIANAPOLIS, INDIANA 46277
20-1-740

8/12/2005

38481

Fall Creek Regional Waste Dist

***5,270.00

PAY TO THE
ORDER OF
Five Thousand Two Hundred Seventy and no/100*****\$

Fall Creek Regional Waste Dist

DOLLARS

MEMO

PH35 + SC651

⑈038481⑈ ⑆074000010⑆

Security Features Included. 

Details on back.