



FALL CREEK REGIONAL WASTE DISTRICT

9378 S. 650 West PO Box 59
Pendleton, IN 46064-0059 778-7544

10-24422.02

APPLICATION FOR SEWER PERMIT

Nº 2374

Date 5/20/96

Permit Void 90 days from Date of Issuance

Owner Name Mike Hart Hart & Hart

Property Address 7570 S SR 67

Lot # _____ P.O. Box _____

Town Pendleton, IN Zip Code 46064

Phone _____ City Water ☒ Well _____

\$ 700.00 Tap on Fee Paid 11/27/96

\$ _____ Inspection fee paid

Application is hereby made for connection to the Fall Creek Regional Waste District Sewer System for the above listed property - Permit Type: Residential _____, Commercial ☒, Industrial _____, or Governmental/Institutional _____. User Information _____.

All workmanship and materials shall conform to the standards of the District Ordinance as described in Ordinance 84-2 and 84-3 as amended. Acceptance and approval must be made by the District inspector or his duly authorized representative before backfilling and final connection is made to the main sewer lines. Any violation of applicable regulations will cause all lines and appurtenances in violation to be removed and replaced at the owners expense.

The Fall Creek Regional Waste District is responsible for the inspection, approval of materials, and installation techniques only. All costs for materials and installation and any liabilities resulting from same is the sole responsibility of the property owner.

I have read and fully understand the above provisions and agree to comply by said provisions.

APPLICANT(S) SIGNATURE

INSPECTOR DH

Date inspected 5/22/96 Approved ☒ Rejected _____

Reason for rejection _____

Date reinspected _____ Approved _____ Rejected _____

Notes:

Size Pipe 4" IAT. / 1 1/4 FM.

Type Pipe PVC / 1/2" PEX

Basement Yes _____ No ☒

Sump Pump Yes _____ No ☒

Downspout to Ground Yes ☒ No _____

Septic Tank Pumped & filled Yes _____ No _____


Contractor Signature Plumb. / CAROL BURTON

Special Conditions _____

(ADVISED TO INSTALL CLEAN OUT)

Existing Home _____

New Construction _____

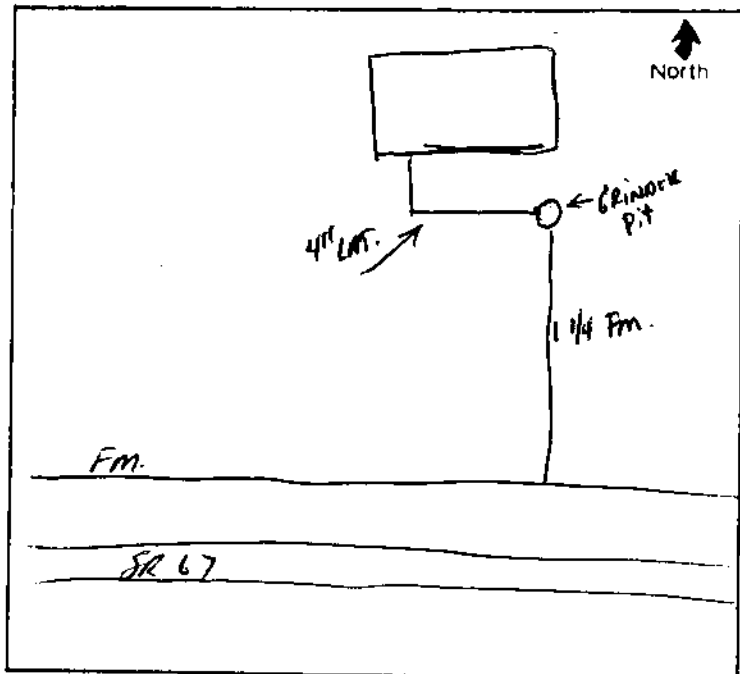



HART AUTO SALES, INC.
7558 STATE ROAD 67 SOUTH
PENDLETON, IN 46084

EXPLANATION	AMOUNT

6674

71-167-749

CHECK
AMOUNT

PAY
AMOUNT
OF

DOLLARS

DATE	TO THE ORDER OF	DESCRIPTION	CHECK NUMBER
4/26	Farm Credit Regional	Harley / for fee	6674

\$700⁰⁰

Security Features
Included
Only on Check

STAR FINANCIAL BANK
ANDERSON, IN 46015

⑈006674⑈ +⑈074901672⑈