


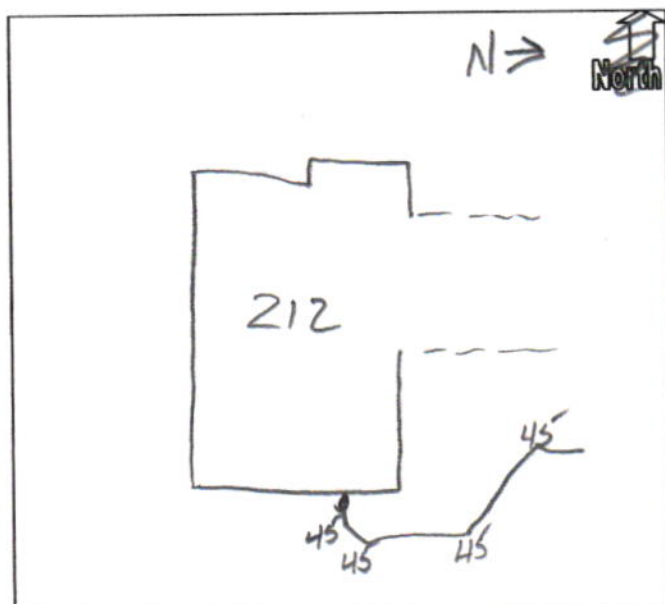

C.P. MORGAN COMMUNITIES, LP
CONSTRUCTION ACCOUNT

JPMORGAN CHASE BANK, N.A.
INDIANAPOLIS, INDIANA 46277
20-1-740

40629

4/10/2006

PAY TO THE
ORDER OF
Fall Creek Regional Waste Dist
Four Hundred Seventy-Five and no/100*****

*****475.00
\$

Fall Creek Regional Waste Dist

DOLLARS

MEMO 107212

⑈040629⑈ ⑆

Donna Davis

MP

