




SUBJECT Partial inspect for  
barn only

SHEET \_\_\_\_\_ OF \_\_\_\_\_

DATE 10-18-18

JOB NO. \_\_\_\_\_

BY Don M

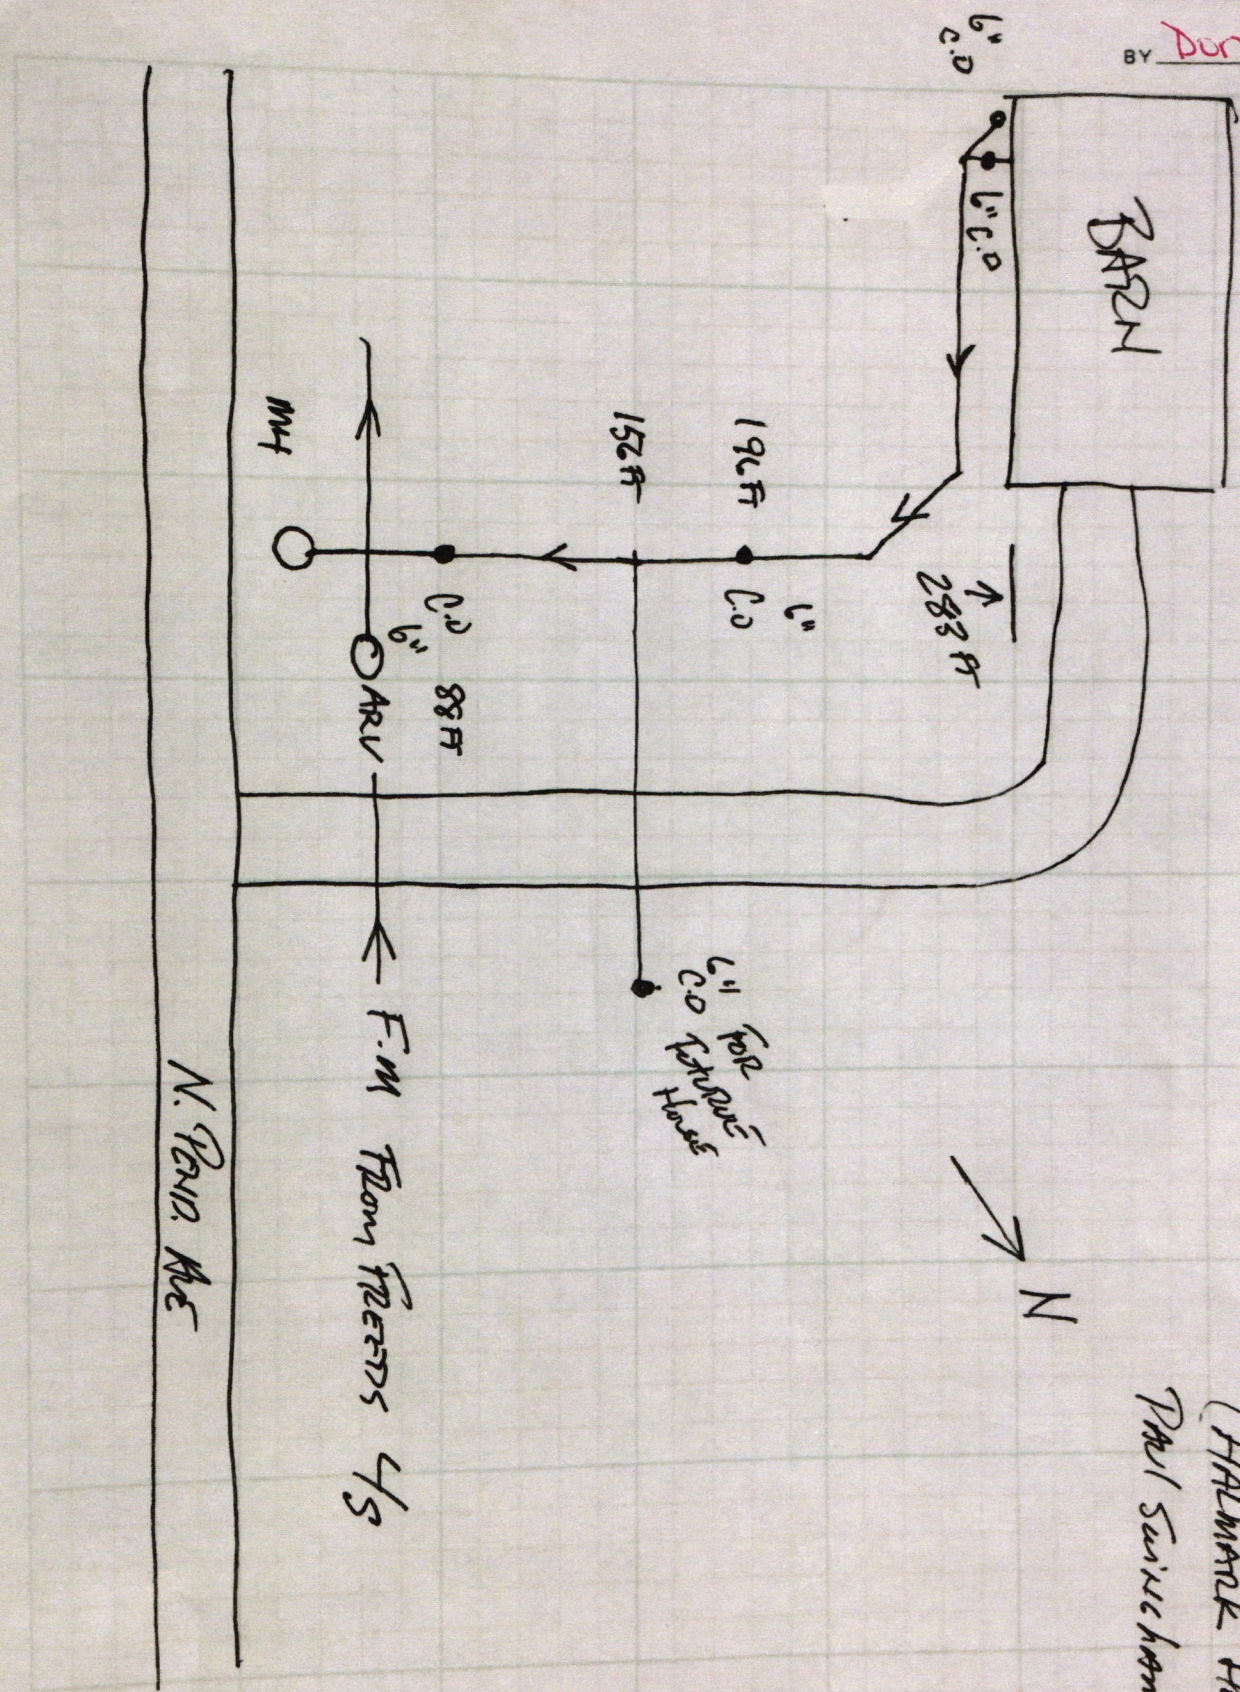

10-18-18  
771 S. Penn Ave  
(HALLMARK HOMES)  
Paul Seivichhammer



771 N Pendleton Ave Partial Connect (Burn) Don Moore 10-18-18






711 N. Pendleton Ave Partial connect (Beurn) Don Moore 10-18-18






711 N Penobscot Ave Partial Connect (Burn) Don Moore 10-18-18

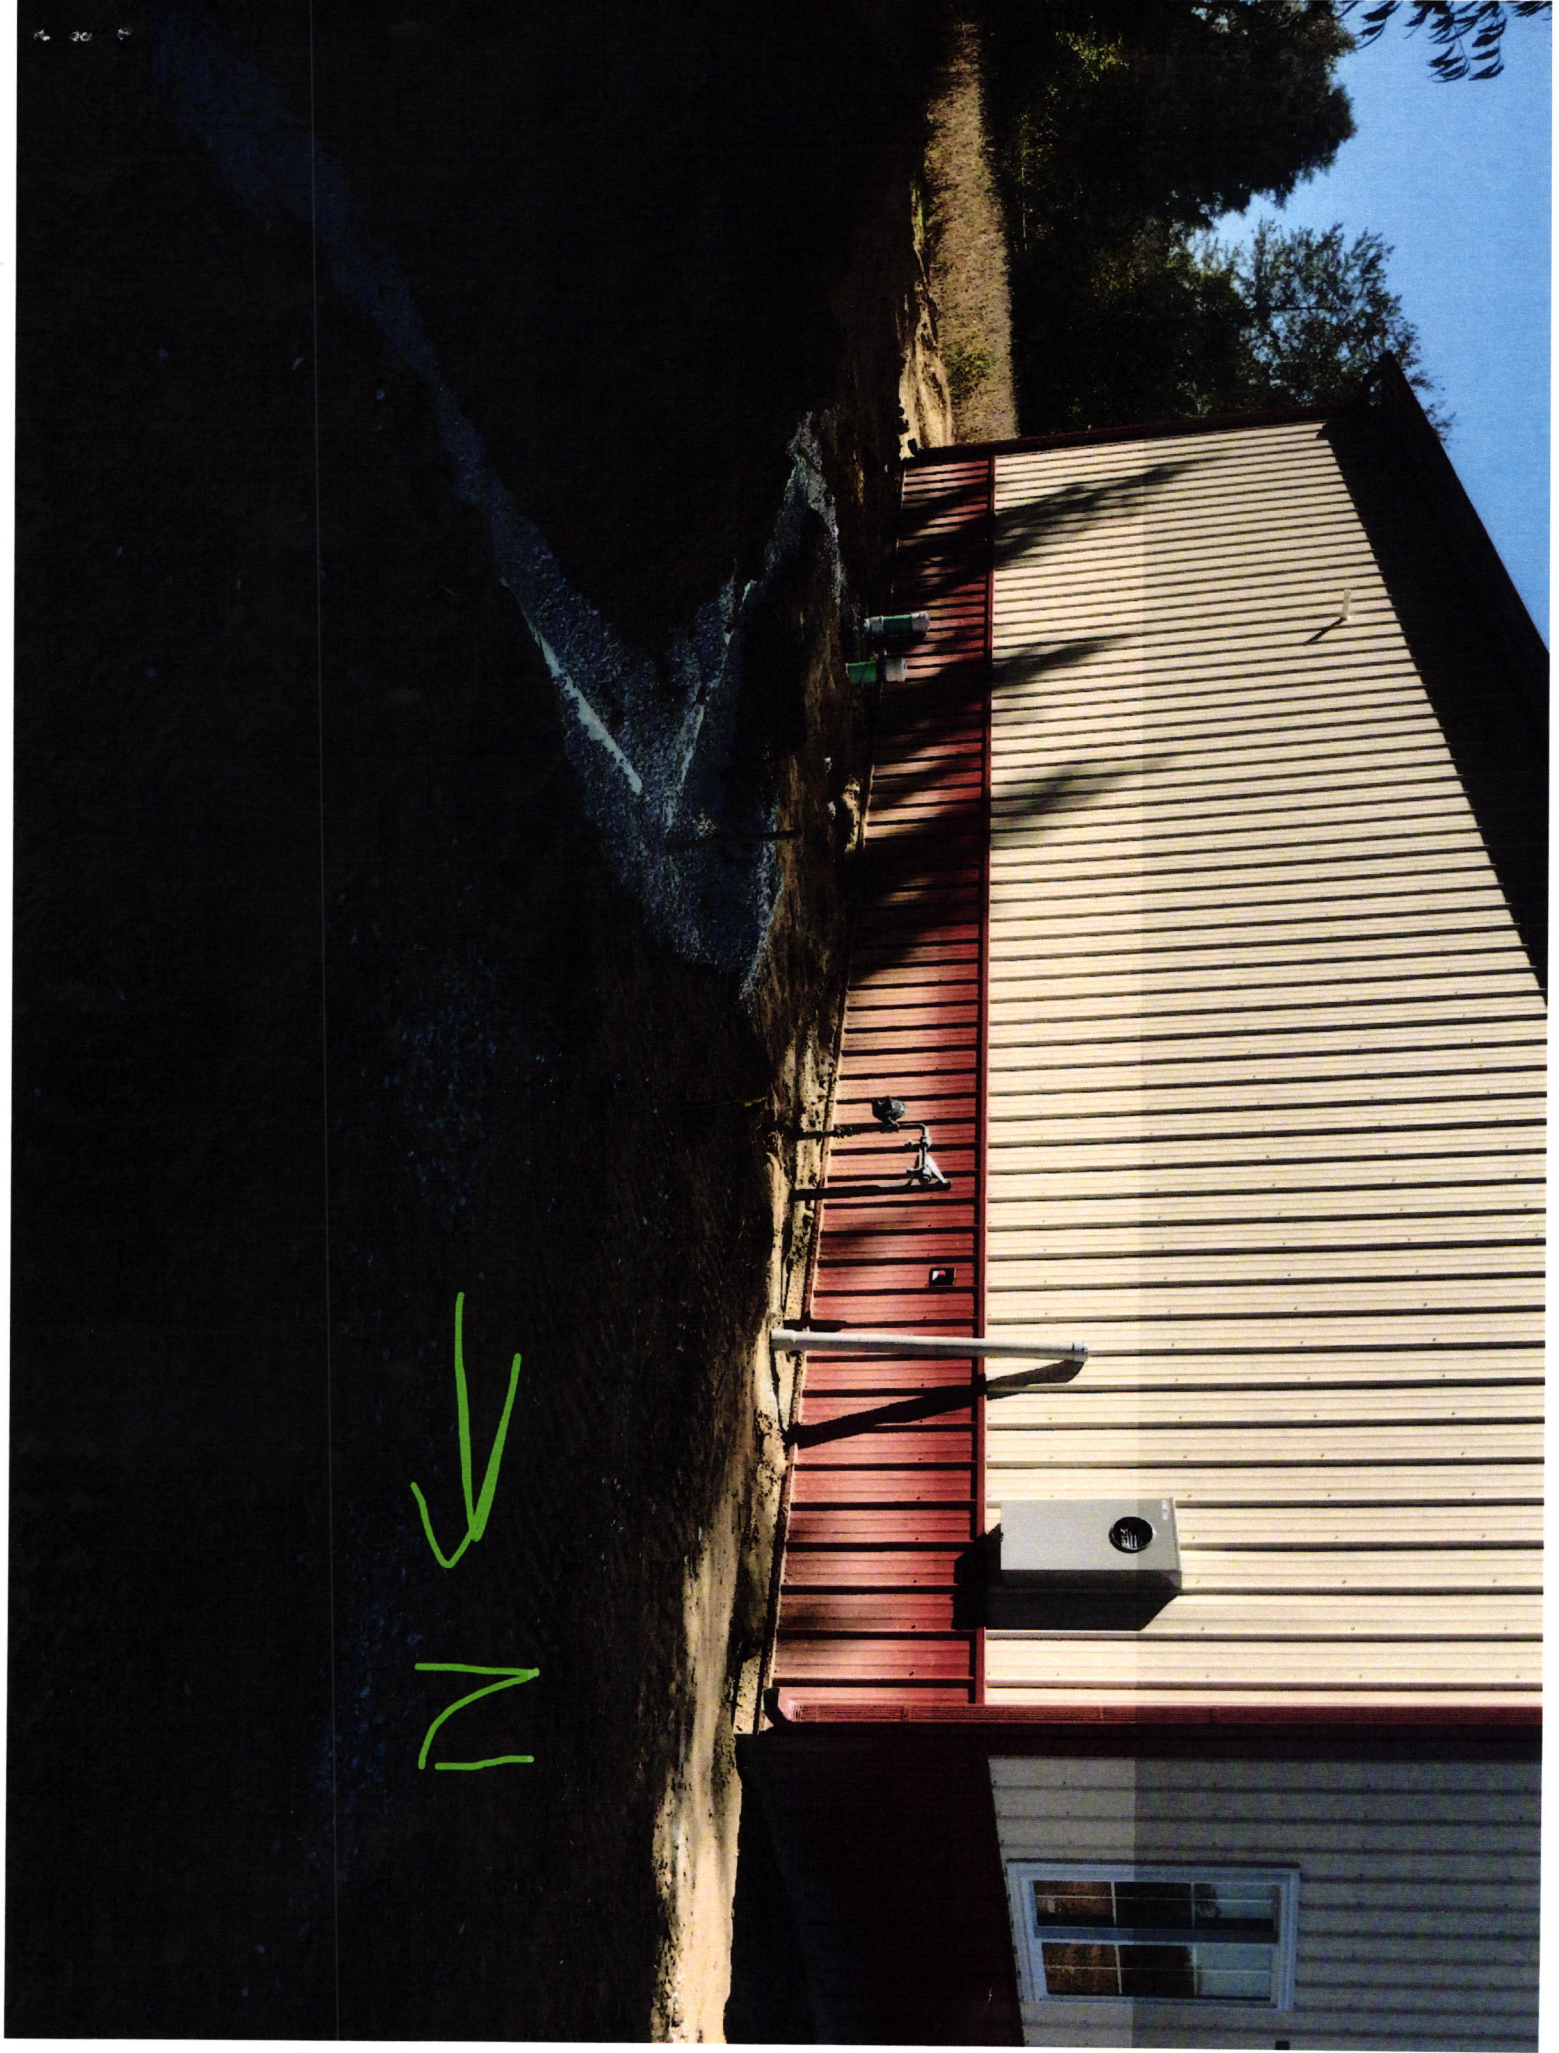

N



771 N Pendleton Ave.

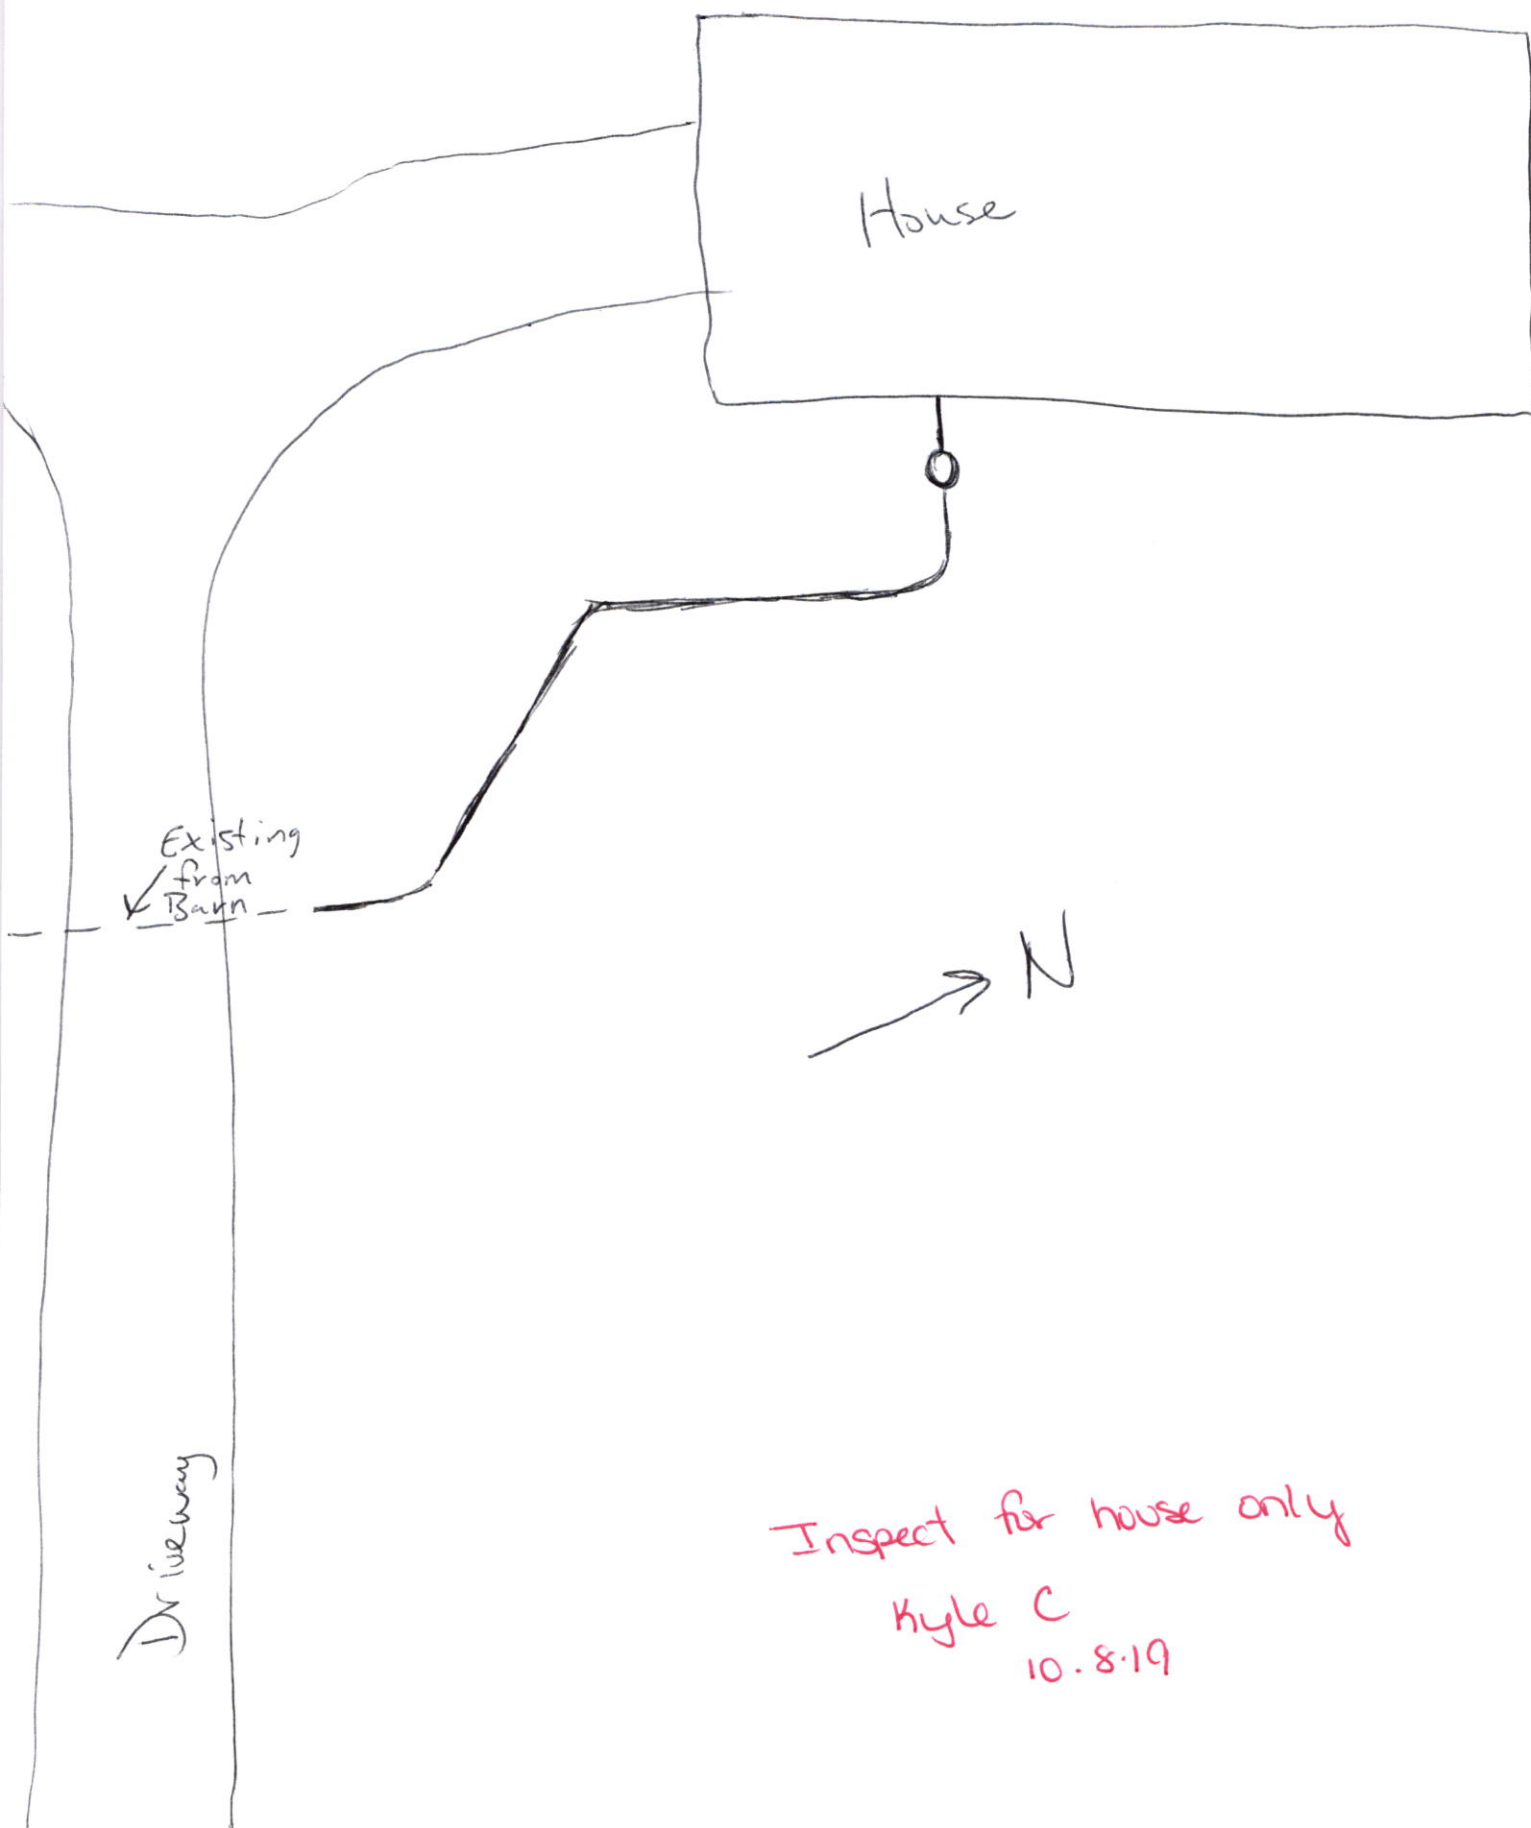

Inspect for house only

Kyle C

10.8.19













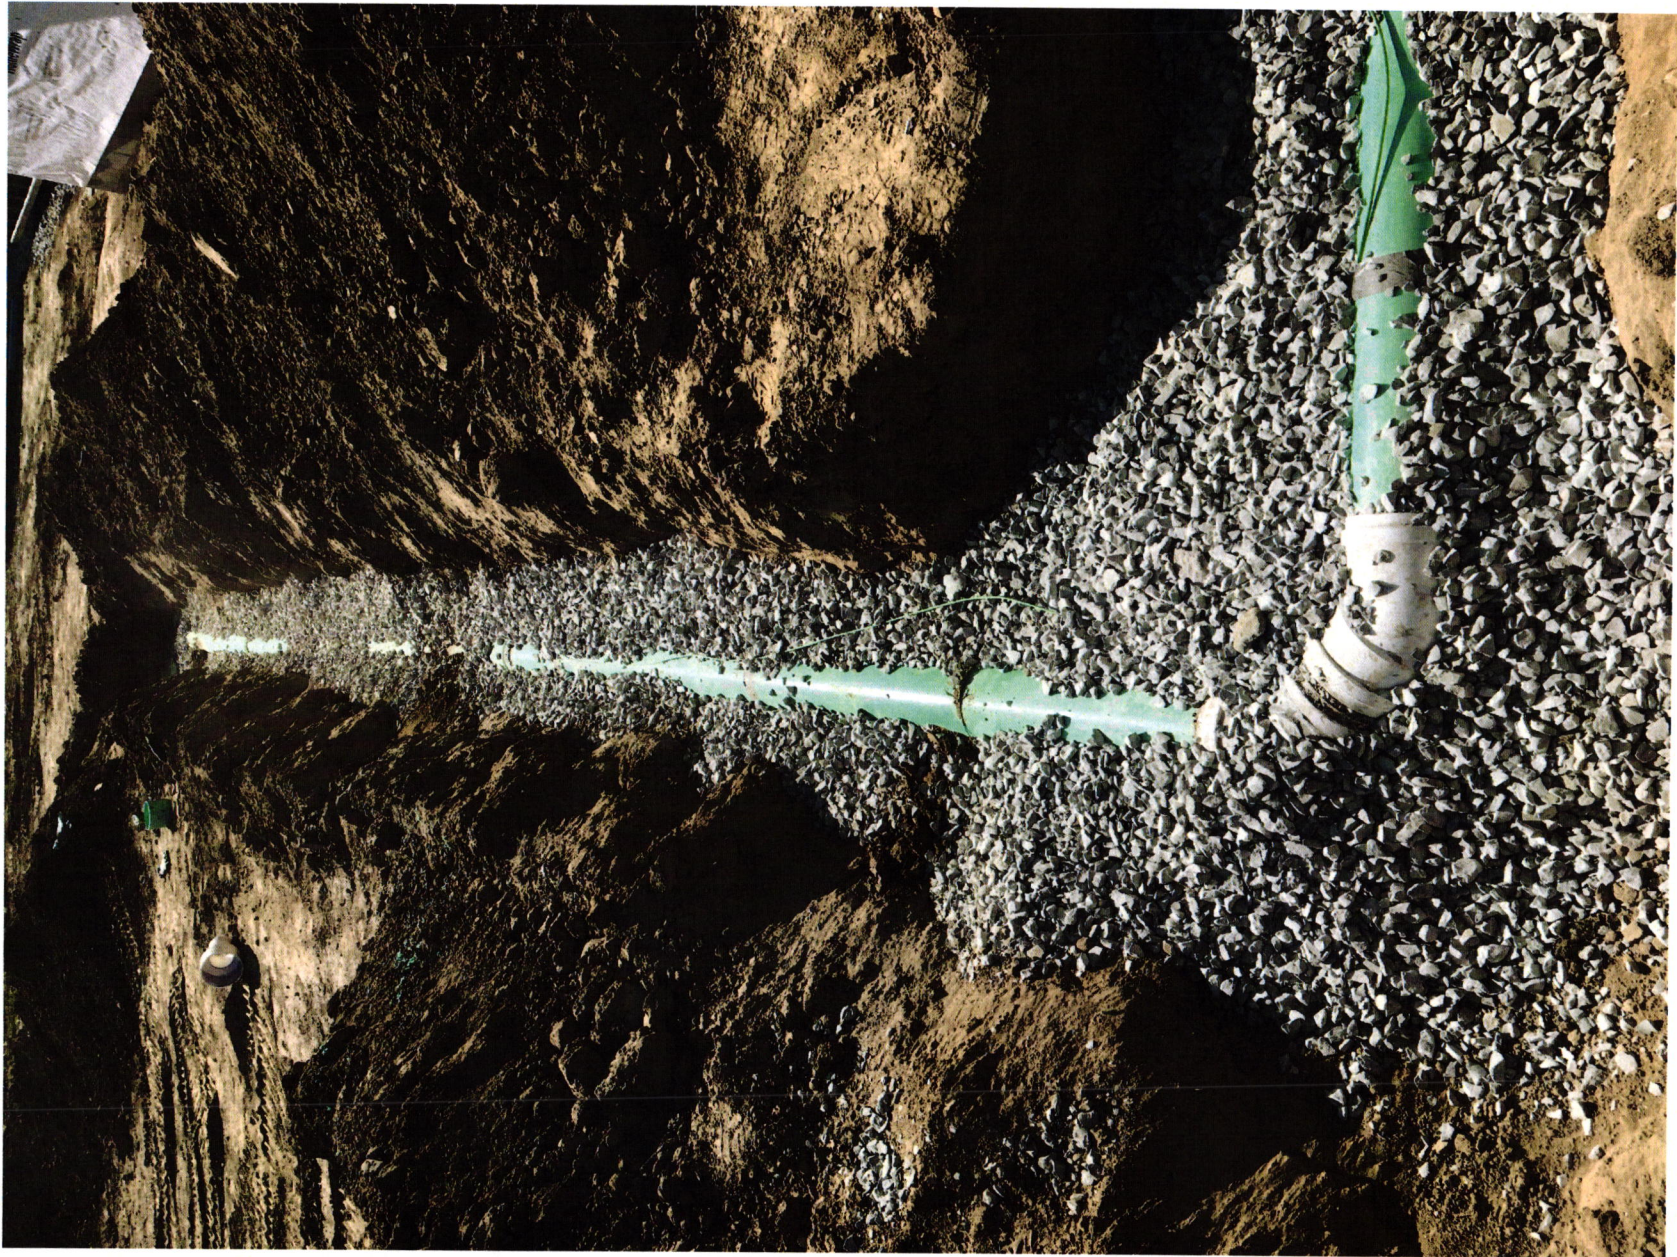



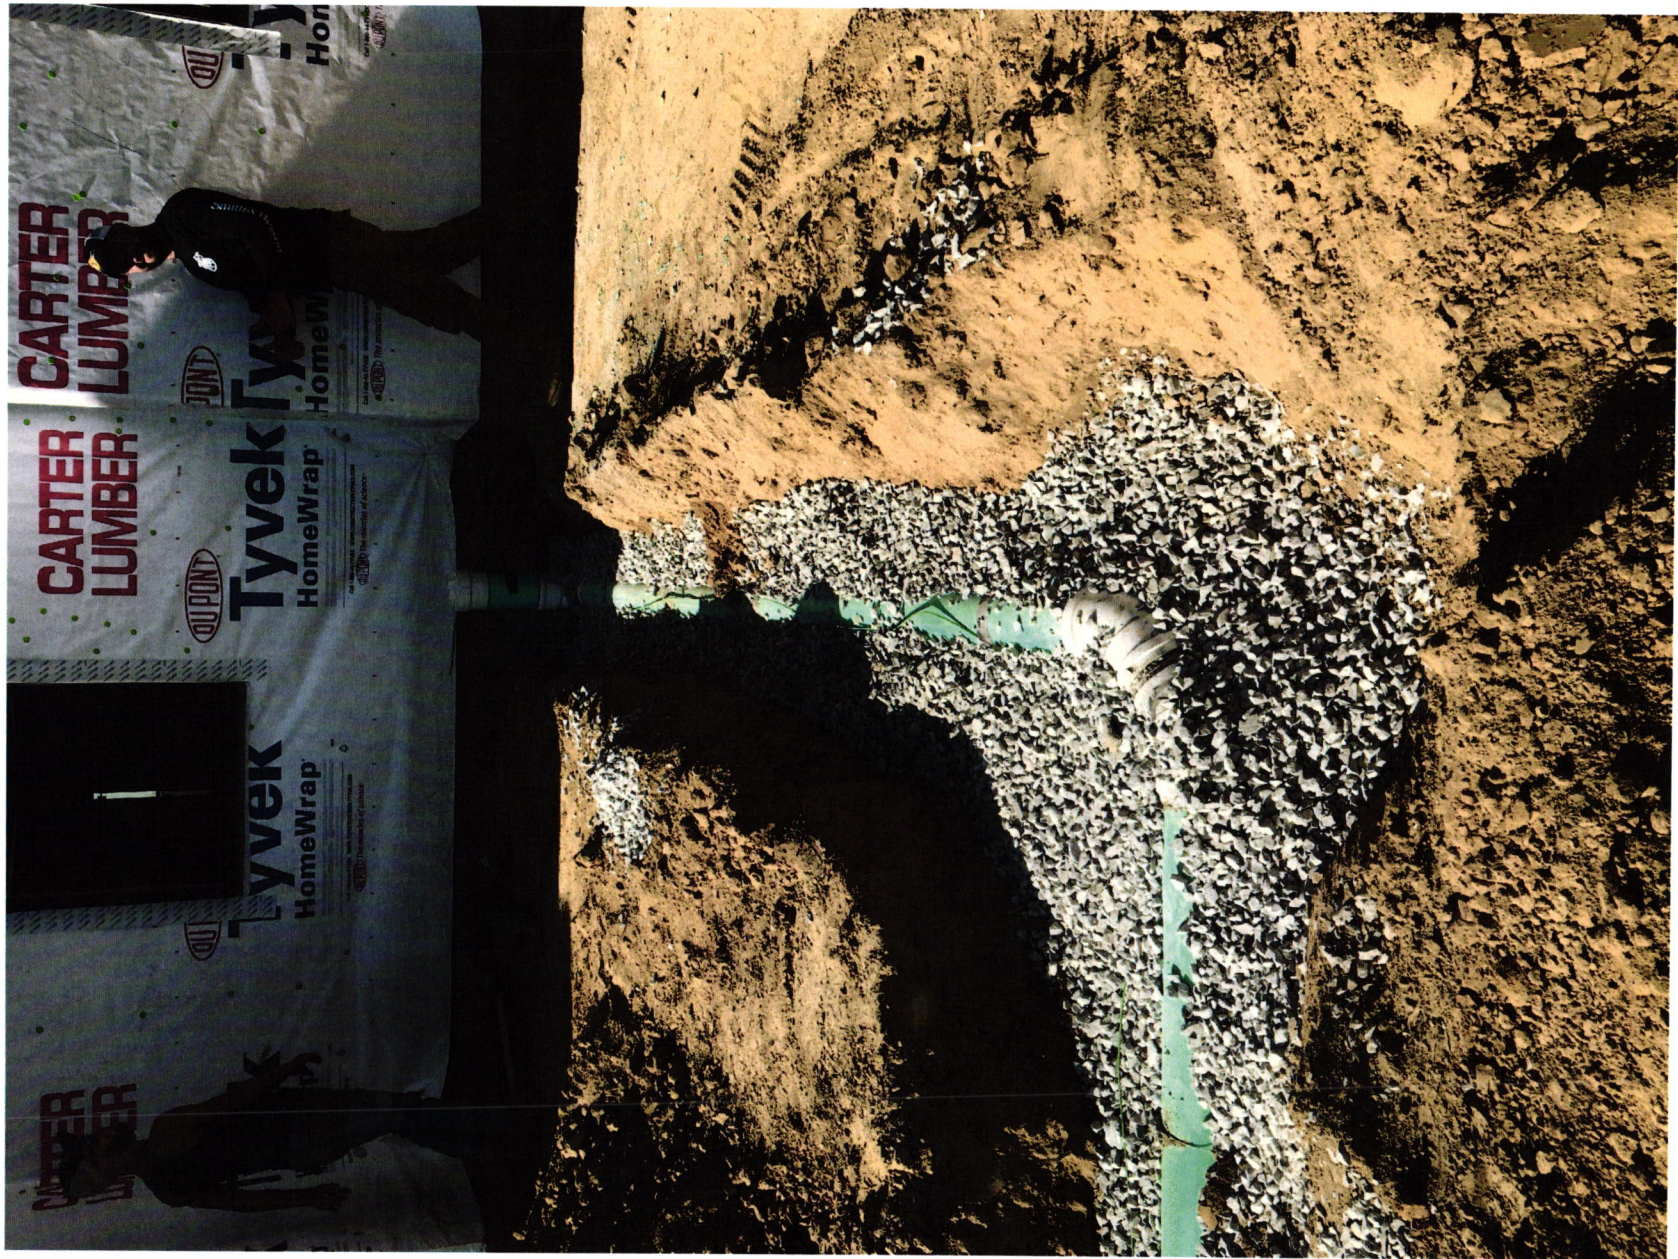



FALL CREEK REGIONAL WASTE DISTRI  
9378 S 650 W  
PO BOX 59  
PENDLETON, IN 46064  
765-778-7544

FALL CREEK REGIONAL WASTE DIST  
0005560008022120839000

Date: 08/23/2018 02:25:34 PM

CREDIT CARD SALE

VISA

CARD NUMBER: \*\*\*\*\*0241 K

TRAN AMOUNT: \$3,370.00

APPROVAL CD: 06039D

ECI:

RECORD #: 000

CLERK ID: Rachel

SALES TAX: \$0.00

INVOICE #: 6759

X

paul schwinghammer

I AGREE TO PAY THE ABOVE TOTAL AMOUNT  
ACCORDING TO THE CARD ISSUER AGREEMENT  
(MERCHANT AGREEMENT IF CREDIT VOUCHER)

Thank you for your business!

Merchant Copy

lec # 010805