

Agreement for Sanitary Sewer Service

This Agreement made and entered into this 30 day of March, 2015, between Fall Creek Regional Waste District ("District") and Shoopman Homes ("Applicant") regarding the provision of sanitary sewer service, and the assignment of capacity in and connection to, the District's facilities for the premises located at 7726 Rose Lane lot # 213 Prairie Hollow

Now therefore, the parties, in consideration of the mutual promises set out in this Agreement, the receipt and sufficiency of which is hereby acknowledged, agree as follows:


1. The Applicant agrees that all workmanship and materials shall conform to all District ordinances and the District's construction standards. District must accept and approve all work and materials before backfilling and final connection is made to the sewer mains. Any violation of this provision will cause all lines and appurtenances in violation to be removed and replaced at the Applicant's expense.
2. The District shall have the right to enter upon the Applicant's premises at all reasonable times to inspect, repair, or replace any equipment used in connection with the District's service or which has an impact on said service.
3. The Applicant shall be responsible for all monthly user rates, capacity charges, and tap fees. The failure to pay any rate charge or fee may result in a lien against the property and/or the termination of service to the property, the cost of which will be borne by Applicant, including, but not limited to, all attorney's fees and collection costs.
4. The District shall not be responsible for any damages as a result of any failure to supply service unless said damages are due to default, neglect or culpability on the part of the District.
5. If there is an available sanitary sewer within three hundred (300) feet of the property line, the property owner shall be required to connect to the District's sanitary sewer system.
6. The Applicant and District agree that the provision of sanitary sewer service touches and concerns the property and the terms of this Agreement bind the District and Applicant and their heirs, executors, administrators, personal representatives, successors, agents, attorneys, assigns, designees, and transferees.

The parties hereto have read and fully understand the above provisions and agree to comply with said provisions.

FALL CREEK REGIONAL WASTE DISTRICT
Rachel E. Andersen
 Signature

APPLICANT

Signature _____

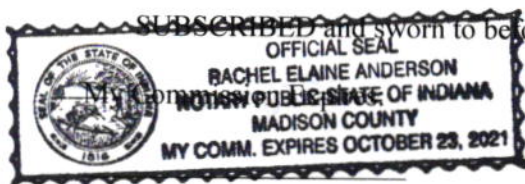[illegible]

30 day of March, 2015
Signature Rachel E. Anders
Printed Rachel E. Anderson
Notary Public
Resident of Madison County

Resident of Madison County


***** Resident of Maricopa County *****

Inspector ABW Date Inspected 5-6-15 Approved ✓ Rejected _____
Reason for Rejection _____

Reason for Rejection _____

Date Reinspected _____ Approved _____ Rejected _____

Notes: _____
Size Pipe 6" Type Pipe PVC 35
Basement Yes No
Sump Pump Yes No
Downspout to Ground Yes No
Septic Tank Pumped & Filled Yes No
Contractor 135, INC. (MOOREBURNE, TN)
Special Conditions _____
Existing Home _____
New Construction ✓

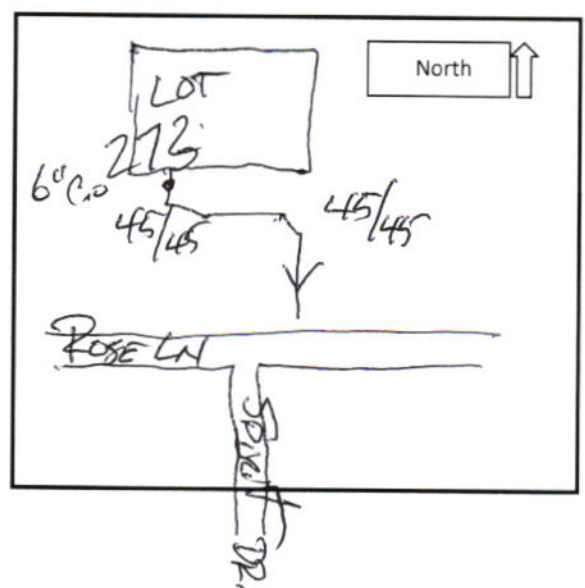

PAUL SHOOPMAN HOME BUILDING GROUP, INC.

11731 COLD CREEK COURT
ZIONSVILLE, IN 46077
PH. 317-733-9810



THE NATIONAL
BANK OF INDIANAPOLIS

Our City. Your Bank.

20-667-740

65290

DATE 3-30-15

AMOUNT

13370.00

PAY
TO THE
ORDER
OF

Three thousand three hundred seventy and $\frac{00}{100}$
Fall Creek Regional Waste District

AUTHORIZED SIGNATURE

⑈065290⑈

Rec # 010333
Cap fee
Tap fee
Pd on 3-30-15

