



# FALL CREEK REGIONAL WASTE DISTRICT

9378 S. 650 West PO Box 59  
Pendleton, IN 46064-0059 778-7544

add order  
on file

26-06072.00

## APPLICATION FOR SEWER PERMIT

Nº 2949

Date 11-17-00

Permit Void 90 days from Date of Issuance

Owner Name DENNIS + JULIE MICKOW

Property Address 7726 W. 1050 S.

Lot # 8

P.O. Box

Town FORTVILLE

IN Zip Code 46040

Phone 317-898-2105

City Water Well ☒

\$ 2556.00

Tap on Fee Paid

\$ N/A

Inspection fee paid

\$1024.80 grinder unit pd 5/18/01

Application is hereby made for connection to the Fall Creek Regional Waste District Sewer System for the above listed property - Permit Type: Residential ☒, Commercial ☐, Industrial ☐, or Governmental/Institutional ☐. User Information

All workmanship and materials shall conform to the standards of the District Ordinance as described in Ordinance 84-2 and 84-3 as amended. Acceptance and approval must be made by the District inspector or his duly authorized representative before backfilling and final connection is made to the main sewer lines. Any violation of applicable regulations will cause all lines and appurtenances in violation to be removed and replaced at the owners expense.

The Fall Creek Regional Waste District is responsible for the inspection, approval of materials, and installation techniques only. All costs for materials and installation and any liabilities resulting from same is the sole responsibility of the property owner.

I have read and fully understand the above provisions and agree to comply by said provisions.

Dennis D. Mickow Julie Mickow  
APPLICANT(S) SIGNATURE

INSPECTOR B

Date inspected 6-27-01

Approved ☒

Rejected

Reason for rejection

Date reinspected

Approved

Rejected

### Notes:

Size Pipe 4" / 1 1/4"

Type Pipe POL 35 / 160

Basement Yes No ☒

Sump Pump Yes No ☒

Downspout to Ground Yes ☒ No


Septic Tank Pumped & filled Yes No ☒

Contractor Ted

Special Conditions

Existing Home

New Construction ☒

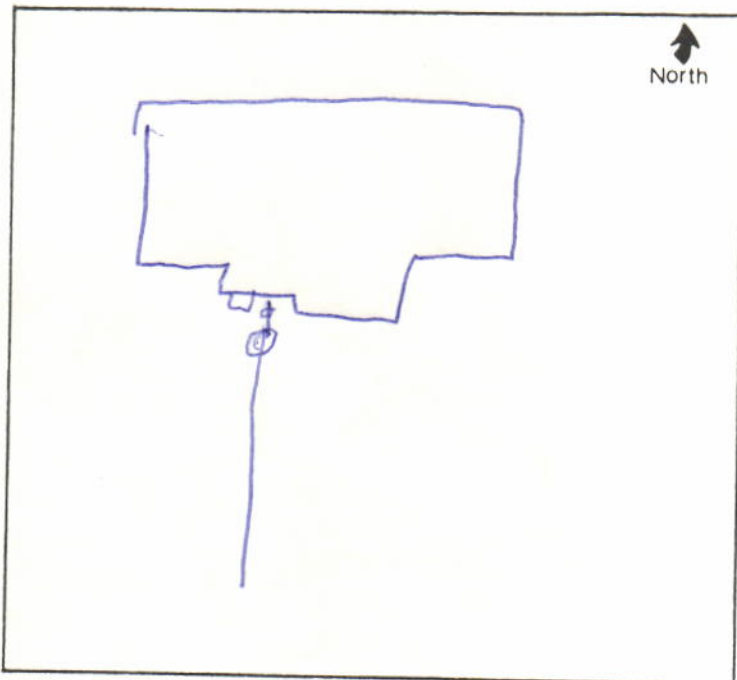



## FALL CREEK REGIONAL WASTE DISTRICT

P.O. Box 59 • 9378 S. 650 West • Pendleton, Indiana 46064-0059 • (765) 778-7544

---

November 15, 2000

Mr. Dennis Mickow  
7726 W 1050 S  
Fortville, IN 46040

Dear Mr. Mickow:

Here is a breakdown of what it will cost you to connect to Fall Creek Regional Waste District's sewer system.

Capacity Fee	\$2156.00
Tap Fee	400.00
Grinder Unit	<u>1024.80</u>
Total	\$3580.80

You will need to come to our office at 9378 S 650 West, Pendleton, to obtain a permit and pay these fees. Our office hours are Monday – Friday, 8:00 a.m. – 4:00 p.m. If you have any other questions, please give us a call at 765-778-7544.

Sincerely,

Debbie Wilson  
Assistant Office Manager



Dennis or Julie Mickow  
7316 E. 49th St.  
Indianapolis, IN 46226  
(317) 541-8312


20-7403/2740

2473

Date 5-18-01

Pay  
to the  
order of

Fall Creek Regional Waste \$ 3580.89/100

Thirty five hundred eighty dollars + 89/100 Dollars 

INDIANA TELCO  
CREDIT UNION  
P.O. BOX 50738  
INDIANAPOLIS, IN 46250

Ach Tr: 274074037 Ach Acct: 313627482

For Sewer

D. Julie Mickow

⑆ 274074037 ⑆

3

LICENSED BY SLIT'S 2008 • SLIT'S 2008