

Gidw.

PROJECT Phase II SHEET _____ OF _____


SUBJECT _____ DATE 6-18-18

JOB NO. 4447

BY Atlas

777 S. Pendleton

← N

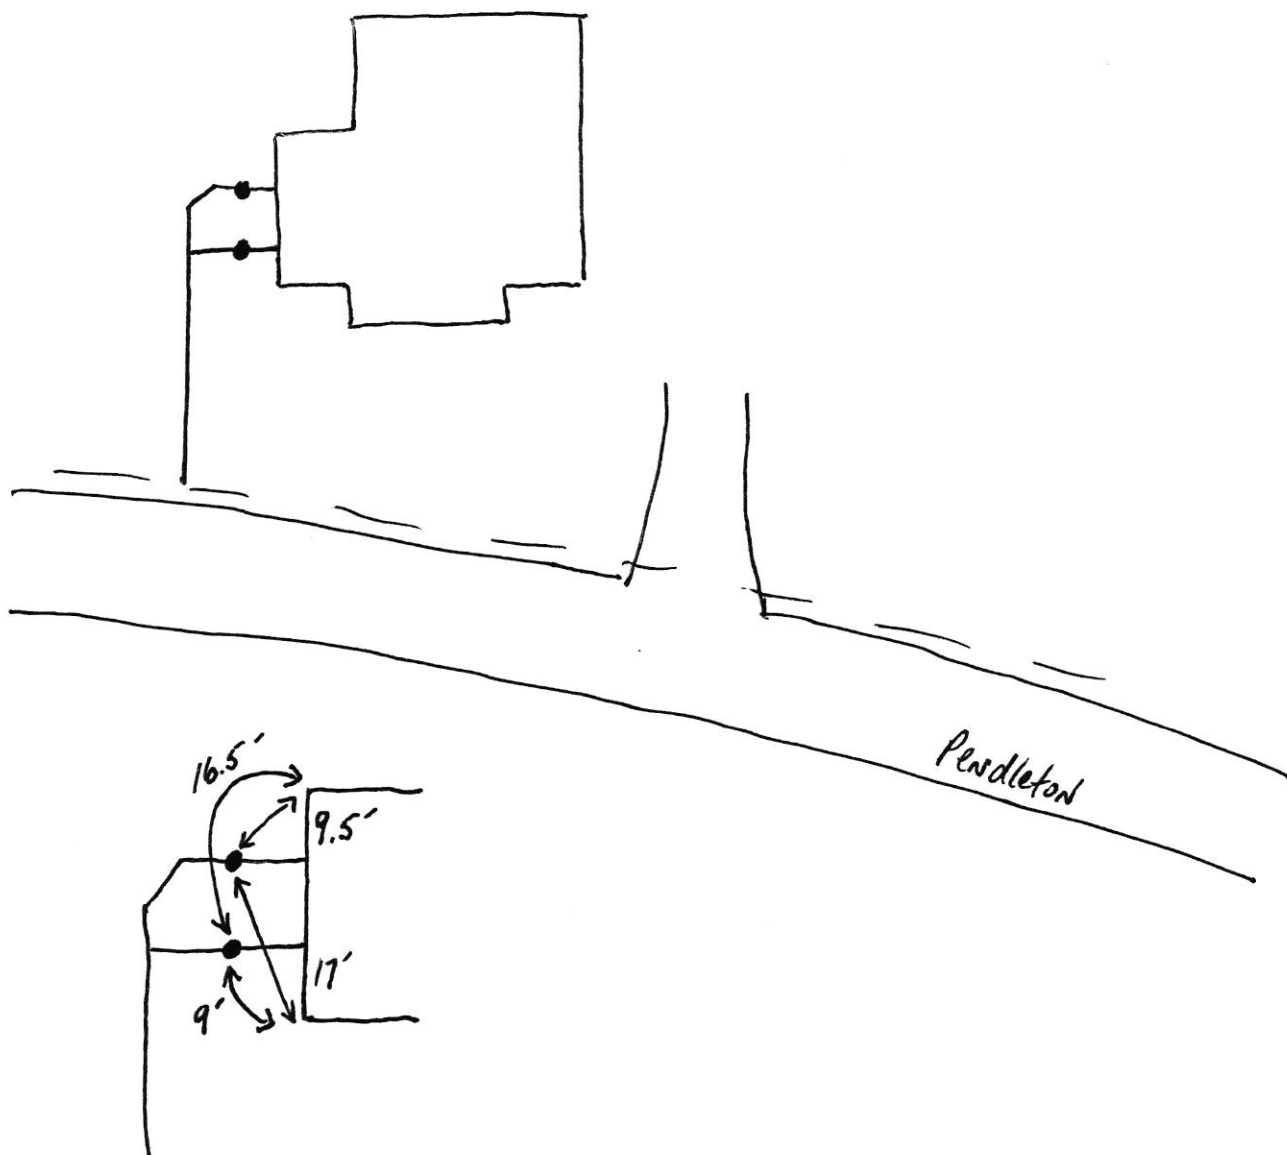

111 S Pendleton Ave

SRP Phase II

6.19.18



TH S Pendleton Ave

SRF Phase II

6.19.18

