

765-778-7544

AGREEMENT FOR SANITARY SEWER SERVICE

NOW THEREFORE, the parties, in consideration of the mutual promises set out in this Agreement, the receipt and sufficiency of which is hereby acknowledged, agree as follows:

1. The Applicant agrees that all workmanship and materials shall conform to all District ordinances and the District's construction standards. District must accept and approve all work and materials before backfilling and final connection is made to the sewer mains. Any violation of this provision will cause all lines and appurtenances in violation to be removed and replaced at the Applicant's expense.
2. The District shall have the right to enter upon the Applicant's premises at all reasonable times to inspect, repair, or replace any equipment used in connection with the District's service or which has an impact on said service.
3. The Applicant shall be responsible for all monthly user rates, capacity charges, and tap fees. The failure to pay any rate charge or fee may result in a lien against the property and/or the termination of service to the property, the cost of which will be borne by Applicant, including, but not limited to, all attorney's fees and collection costs.
4. The District shall not be responsible for any damages as a result of any failure to supply service unless said damages are due to default, neglect or culpability on the part of the District.
5. If there is an available sanitary sewer within three hundred (300) feet of the property line, the property owner shall be required to connect to the District's sanitary sewer system.
6. The Applicant and District agree that the provision of sanitary sewer service touches and concerns the property and the terms of this Agreement bind the District and Applicant and their heirs, executors, administrators, personal representatives, successors, agents, attorneys, assigns, designees, and transferees.

Signature

SUBSCRIBED and sworn to before me this 3rd day of May, 2003

My Commission Expires: 4-19-2008

Signature

Printed

Notary Public
Resident of Madison County

INSPECTOR Don DATE INSPECTED 8/05 APPROVED ✓ REJECTED _____

REASON FOR REJECTION

DATE REINSPECTED _____

APPROVED

REJECTED

NOTES:

SIZE PIPE 4 1/4" TYPE PIPE 35 1/60

BASEMENT YES NO ☒

SUMP PUMP YES NO ☒

DOWNSPOUT TO GROUND YES ☒ NO ☐


SEPTIC TANK PUMPED & FILLED YES NO


CONTRACTOR JEFF Hollowed / Tom Davis etc.

SPECIAL CONDITIONS NO INSPECT DURING

EXISTING HOME

NEW CONSTRUCTION

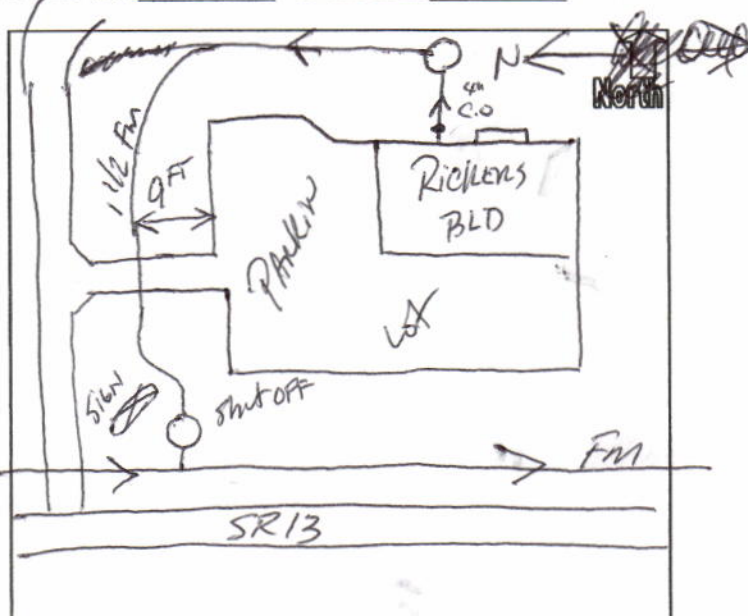

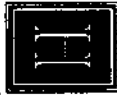

JEFFREY C. HOLLON 07-02
 PH. 765-642-8063
 1106 MERIDIAN PLAZA SUITE 659
 ANDERSON, IN 46016

Date May 5 2005 3771
 71-1/863

PAY to the order of Fall Creek Regional Club District \$ 6955.00
 Six Thousand Nine Hundred Fifty Five and 00/100 Dollars

OLD NATIONAL BANK
 Anderson, Indiana • www.oldnational.com

For EDC's Top Ten
 1:0863000121: 1173880811

Jeffrey C. Hollon