

G.R.W.

PROJECT Phase II SHEET _____ OF _____


SUBJECT _____ DATE 6-16-18

JOB NO. 4447

BY Atlas

779 S. Pendleton

↑
N

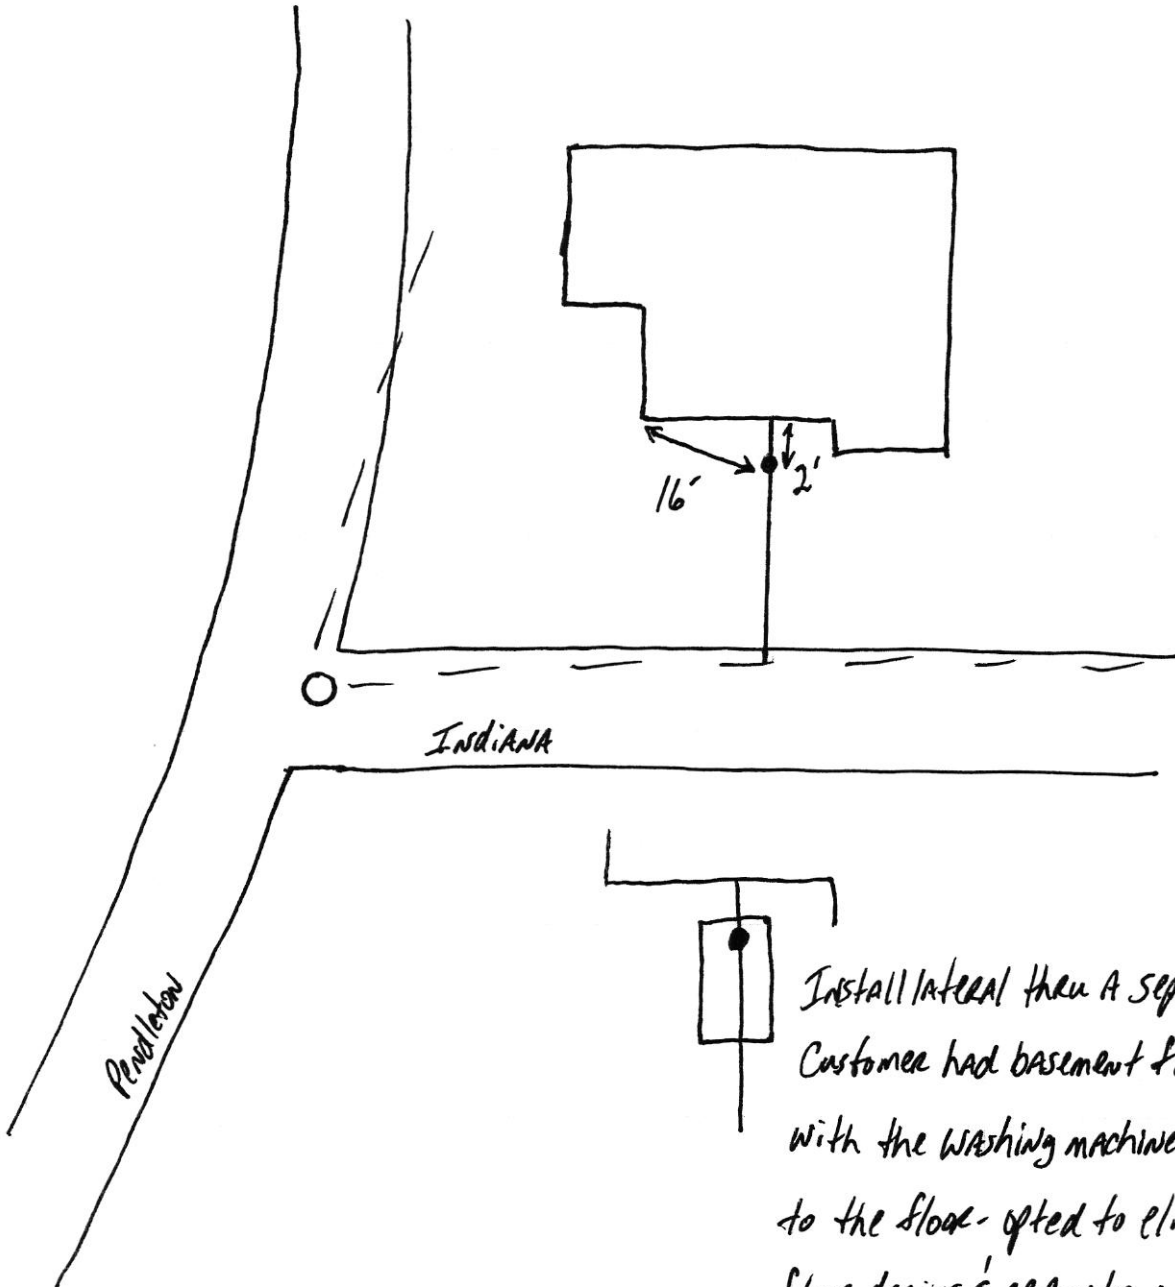

Install lateral thru A septic tank
Customer had basement floor drains
with the washing machine draining
to the floor - opted to eliminate
floor drains & reRoute washing
machine