

#7382

9378 S 650 W, P.O. Box 59, Pendleton, IN 46064

765-778-7544

Agreement for Sanitary Sewer Service

This Agreement made and entered into this 8 day of Dec., 2020, between Fall Creek Regional Waste District ("District") and Yusea Haller ("Applicant") regarding the provision of sanitary sewer service, and the assignment of capacity in and connection to, the District's facilities for the premises located at _____

Street Address: 779 S. Pendleton Ave Rehab

Now therefore, the parties, in consideration of the mutual promises set out in this Agreement, the receipt and sufficiency of which is hereby acknowledged, agree as follows:

1. The Applicant agrees that all workmanship and materials shall conform to all District ordinances and the District's construction standards. District must accept and approve all work and materials before backfilling and final connection is made to the sewer mains. Any violation of this provision will cause all lines and appurtenances in violation to be removed and replaced at the Applicant's expense.
2. The District shall have the right to enter upon the Applicant's premises at all reasonable times to inspect, repair, or replace any equipment used in connection with the District's service or which has an impact on said service.
3. The Applicant shall be responsible for all monthly user rates, capacity charges, and tap fees. The failure to pay any rate charge or fee may result in a lien against the property and/or the termination of service to the property, the cost of which will be borne by Applicant, including, but not limited to, all attorney's fees and collection costs.
4. The District shall not be responsible for any damages as a result of any failure to supply service unless said damages are due to default, neglect or culpability on the part of the District.
5. If there is an available sanitary sewer within three hundred (300) feet of the property line, the property owner shall be required to connect to the District's sanitary sewer system.
6. The Applicant and District agree that the provision of sanitary sewer service touches and concerns the property and the terms of this Agreement bind the District and Applicant and their heirs, executors, administrators, personal representatives, successors, agents, attorneys, assigns, designees, and transferees.

The parties hereto have read and fully understand the above provisions and agree to comply with said provisions.

FALL CREEK REGIONAL WASTE DISTRICT
Signature

APPLICANT

Signature

[illegible]

SUBSCRIBED and sworn to before me this ____ day of _____, 20____

My Commission Expires:

Signature_____

Printed_____

Notary Public

Resident of _____ County

***** Resident of _____ County *****

Inspector SN Date Inspected 12/8/20 Approved ✓ Rejected _____
Reason for Rejection _____

Reason for Rejection _____ Date Reinspected _____ Approved _____ Rejected _____

Notes: _____

Notes:

Size Pipe 41" Type Pipe 40

Basement Yes No

Sump Pump Yes No

Downspout to Ground Yes No


Septic Tank Pumped & Filled Yes No

Contractor Self

Special Conditions _____

Existing Home ☒
 New Construction ☐

New Construction _____

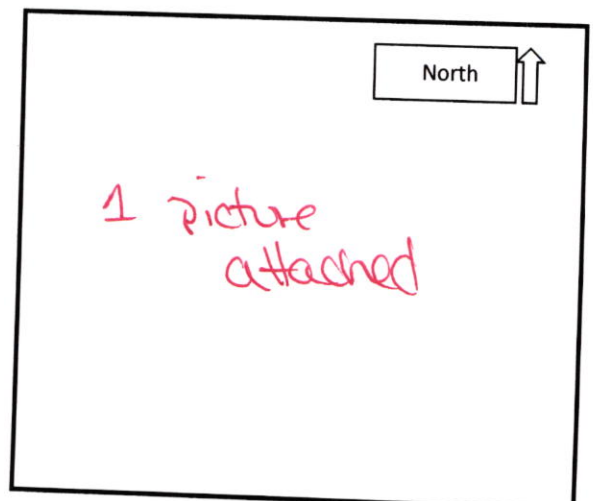



G.R.W.

PROJECT Phase II SHEET _____ OF _____


SUBJECT _____ DATE 6-16-18

JOB NO. 4447

BY Atlas

779 S. Pendleton

↑
N

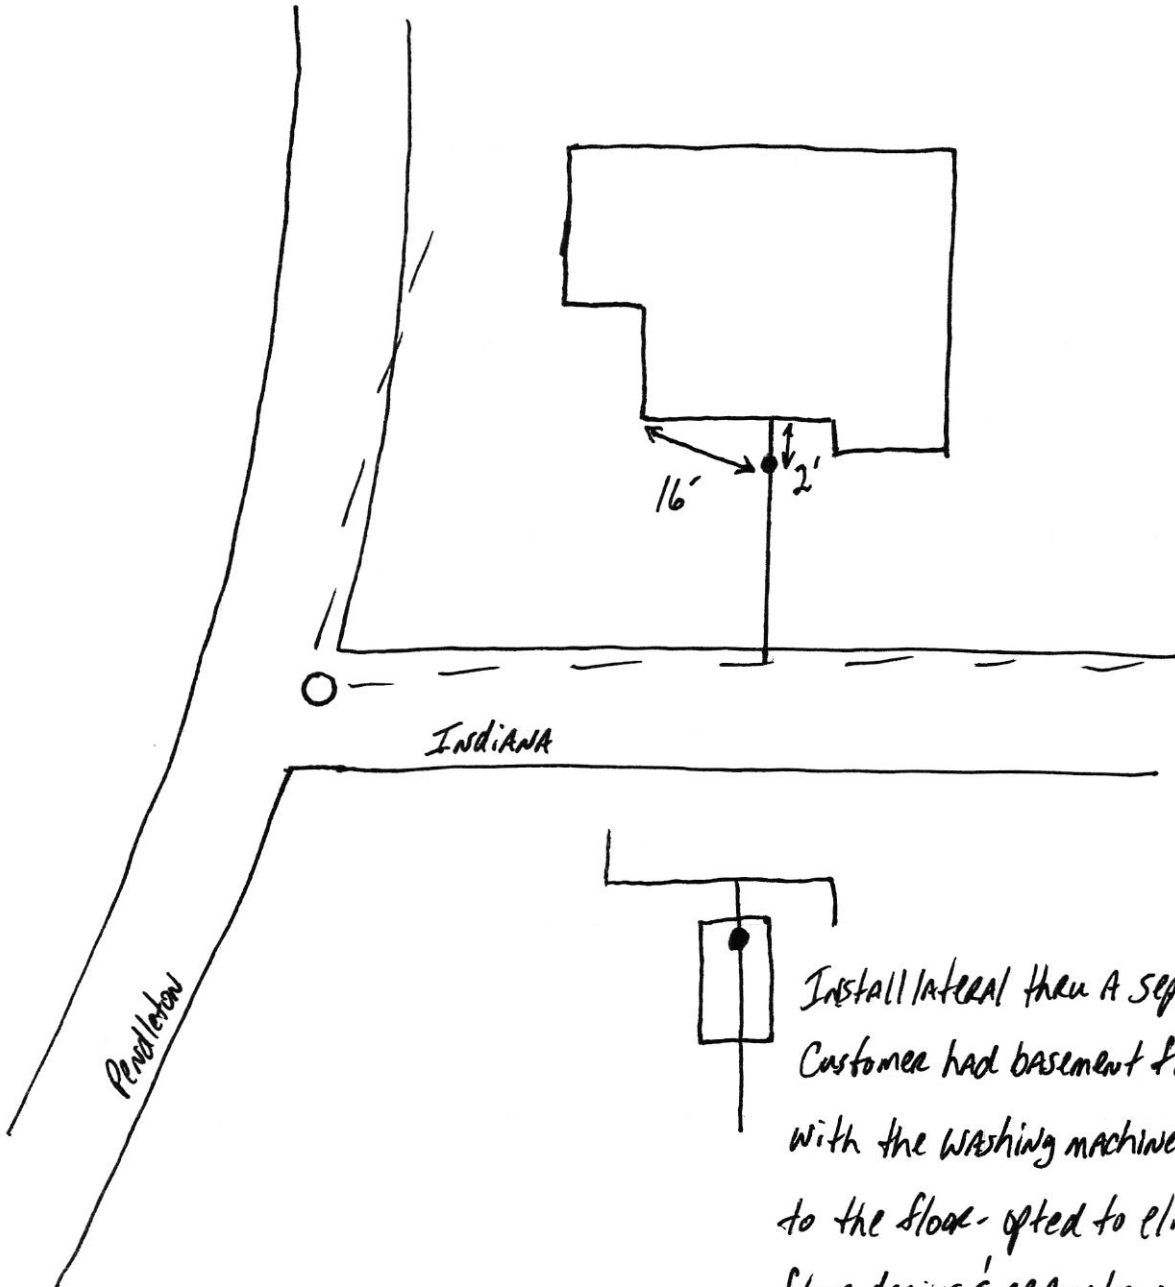

Install lateral thru A septic tank
Customer had basement floor drains
with the washing machine draining
to the floor- opted to eliminate
floor drains & reRoute washing
machine