

13-28464.00

FALL CREEK REGIONAL WASTE DISTRICT

4691

9378 S 650 WEST, P.O. BOX 59, PENDLETON, IN 46064

765-778-7544

AGREEMENT FOR SANITARY SEWER SERVICE

This Agreement made and entered into this 23<sup>rd</sup> day of October, 2002, between FALL CREEK REGIONAL WASTE DISTRICT ("District") and Steve Costerison ("Applicant") regarding the provision of sanitary sewer service, and the assignment of capacity in, and connection to, the District's facilities for the premises located at 780 N. Pendleton Ave.

NOW THEREFORE, the parties, in consideration of the mutual promises set out in this Agreement, the receipt and sufficiency of which is hereby acknowledged, agree as follows:

1. The Applicant agrees that all workmanship and materials shall conform to all District ordinances and the District's construction standards. District must accept and approve all work and materials before backfilling and final connection is made to the sewer mains. Any violation of this provision will cause all lines and appurtenances in violation to be removed and replaced at the Applicant's expense.

2. The District shall have the right to enter upon the Applicant's premises at all reasonable times to inspect, repair, or replace any equipment used in connection with the District's service or which has an impact on said service.

3. The Applicant shall be responsible for all monthly user rates, capacity charges, and tap fees. The failure to pay any rate charge or fee may result in a lien against the property and/or the termination of service to the property, the cost of which will be borne by Applicant, including, but not limited to, all attorney's fees and collection costs.

4. The District shall not be responsible for any damages as a result of any failure to supply service unless said damages are due to default, neglect or culpability on the part of the District.

5. If there is an available sanitary sewer within three hundred (300) feet of the property line, the property owner shall be required to connect to the District's sanitary sewer system.

6. The Applicant and District agree that the provision of sanitary sewer service touches and concerns the property and the terms of this Agreement bind the District and Applicant and their heirs, executors, administrators, personal representatives, successors, agents, attorneys, assigns, designees, and transferees.

The parties hereto have read and fully understand the above provisions and agree to comply with said provisions.

FALL CREEK REGIONAL WASTE DISTRICT

APPLICANT

Signature

Signature

STATE OF INDIANA )  
 ) SS:  
COUNTY OF MADISON )

SUBSCRIBED and sworn to before me this \_\_\_\_\_ day of \_\_\_\_\_, 200\_\_.

My Commission Expires:

Signature \_\_\_\_\_

Printed \_\_\_\_\_

Notary Public  
Resident of Madison County

\*\*\*\*\*  
INSPECTOR B DATE INSPECTED 4-16-03 APPROVED ✓ REJECTED \_\_\_\_\_

REASON FOR REJECTION \_\_\_\_\_

DATE REINSPECTED \_\_\_\_\_ APPROVED \_\_\_\_\_ REJECTED \_\_\_\_\_

NOTES:  
SIZE PIPE 6" TYPE PIPE PVC

BASEMENT YES \_\_\_\_\_ NO ?

SUMP PUMP YES \_\_\_\_\_ NO ✓

DOWNSPOUT TO GROUND YES ✓ NO \_\_\_\_\_


SEPTIC TANK PUMPED & FILLED YES \_\_\_\_\_ NO ✓

CONTRACTOR Don Brown

SPECIAL CONDITIONS \_\_\_\_\_

EXISTING HOME \_\_\_\_\_

NEW CONSTRUCTION ✓

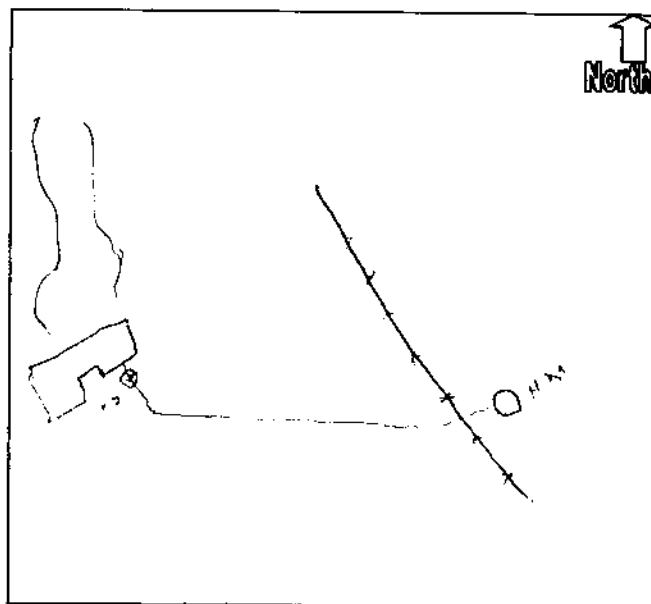

# FALL CREEK REGIONAL WASTE DISTRICT

9378 S 650 WEST, P.O. BOX 59, PENDLETON, IN 46064

765-778-7544

## AGREEMENT FOR SANITARY SEWER SERVICE

This Agreement made and entered into this 23rd day of October, 2002, between FALL CREEK REGIONAL WASTE DISTRICT ("District") and Steve Costerton ("Applicant") regarding the provision of sanitary sewer service, and the assignment of capacity in, and connection to, the District's facilities for the premises located at 780 N. Pendleton Ave.

NOW THEREFORE, the parties, in consideration of the mutual promises set out in this Agreement, the receipt and sufficiency of which is hereby acknowledged, agree as follows:

1. The Applicant agrees that all workmanship and materials shall conform to all District ordinances and the District's construction standards. District must accept and approve all work and materials before backfilling and final connection is made to the sewer mains. Any violation of this provision will cause all lines and appurtenances in violation to be removed and replaced at the Applicant's expense.

2. The District shall have the right to enter upon the Applicant's premises at all reasonable times to inspect, repair, or replace any equipment used in connection with the District's service or which has an impact on said service.

3. The Applicant shall be responsible for all monthly user rates, capacity charges, and tap fees. The failure to pay any rate charge or fee may result in a lien against the property and/or the termination of service to the property, the cost of which will be borne by Applicant, including, but not limited to, all attorney's fees and collection costs.

4. The District shall not be responsible for any damages as a result of any failure to supply service unless said damages are due to default, neglect or culpability on the part of the District.

5. If there is an available sanitary sewer within three hundred (300) feet of the property line, the property owner shall be required to connect to the District's sanitary sewer system.

6. The Applicant and District agree that the provision of sanitary sewer service touches and concerns the property and the terms of this Agreement bind the District and Applicant and their heirs, executors, administrators, personal representatives, successors, agents, attorneys, assigns, designees, and transferees.

The parties hereto have read and fully understand the above provisions and agree to comply with said provisions.

FALL CREEK REGIONAL WASTE DISTRICT

APPLICANT

Signature

Signature

STATE OF INDIANA )

) SS:

COUNTY OF MADISON )

SUBSCRIBED and sworn to before me this \_\_\_\_\_ day of \_\_\_\_\_, 200\_\_.

My Commission Expires:

Signature

Printed

Notary Public

Resident of Madison County

\*\*\*\*\*  
INSPECTOR B DATE INSPECTED 4-16-23 APPROVED ✓ REJECTED \_\_\_\_\_

REASON FOR REJECTION \_\_\_\_\_

DATE REINSPECTED \_\_\_\_\_ APPROVED \_\_\_\_\_ REJECTED \_\_\_\_\_

NOTES:

SIZE PIPE 6" TYPE PIPE PVC

BASEMENT YES \_\_\_\_\_ NO ?

SUMP PUMP YES \_\_\_\_\_ NO ✓

DOWNSPOUT TO GROUND YES ✓ NO \_\_\_\_\_


SEPTIC TANK PUMPED & FILLED YES \_\_\_\_\_ NO ✓

CONTRACTOR Don Brown

SPECIAL CONDITIONS \_\_\_\_\_

EXISTING HOME \_\_\_\_\_

NEW CONSTRUCTION ✓

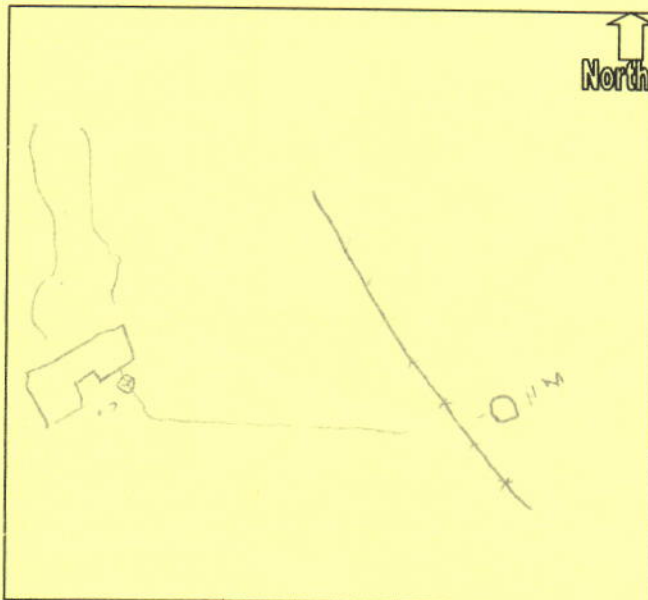





PROJECT: \_\_\_\_\_

DATE: \_\_\_\_\_

CONSTRUCTION SERVICES

RESIDENTIAL  
COMMERCIAL  
MUNICIPAL  
INDUSTRIAL

GENERAL CONSTRUCTION  
DEMOLITION  
PAVING  
SEWER MAINS & SERVICES  
SEWER PUMP STATIONS  
SEWER MAINS & SERVICES  
SEWER TREATMENT PLANTS & GRINDERS  
SEWER  
SITE WORK  
BUILDINGS  
EXCAVATING

ELECTRICAL SERVICES

WIRE INSERTION  
COPING  
WIRE HOT TAPS  
DETECTION  
WIRE TESTING  
LOCATION AND  
LOCATION  
RIGGING DIVING

CONCRETE SERVICES

CONCRETE RELINING  
CONCRETE GROUTING  
JOINT SEALS  
CONCRETE CASTING REPAIR  
REPLACEMENT  
ACCESSMENT  
PATCH  
VAC  
CLEANING  
TELEVISION  
EQUIPMENT REPAIRS

EMERGENCY  
CUT AND SERVICE  
SAFETY TRAINED


(65) 584-8509

(65) 584-8060

TRIAL PARK DRIVE

INTER IN 47394

contracting.com

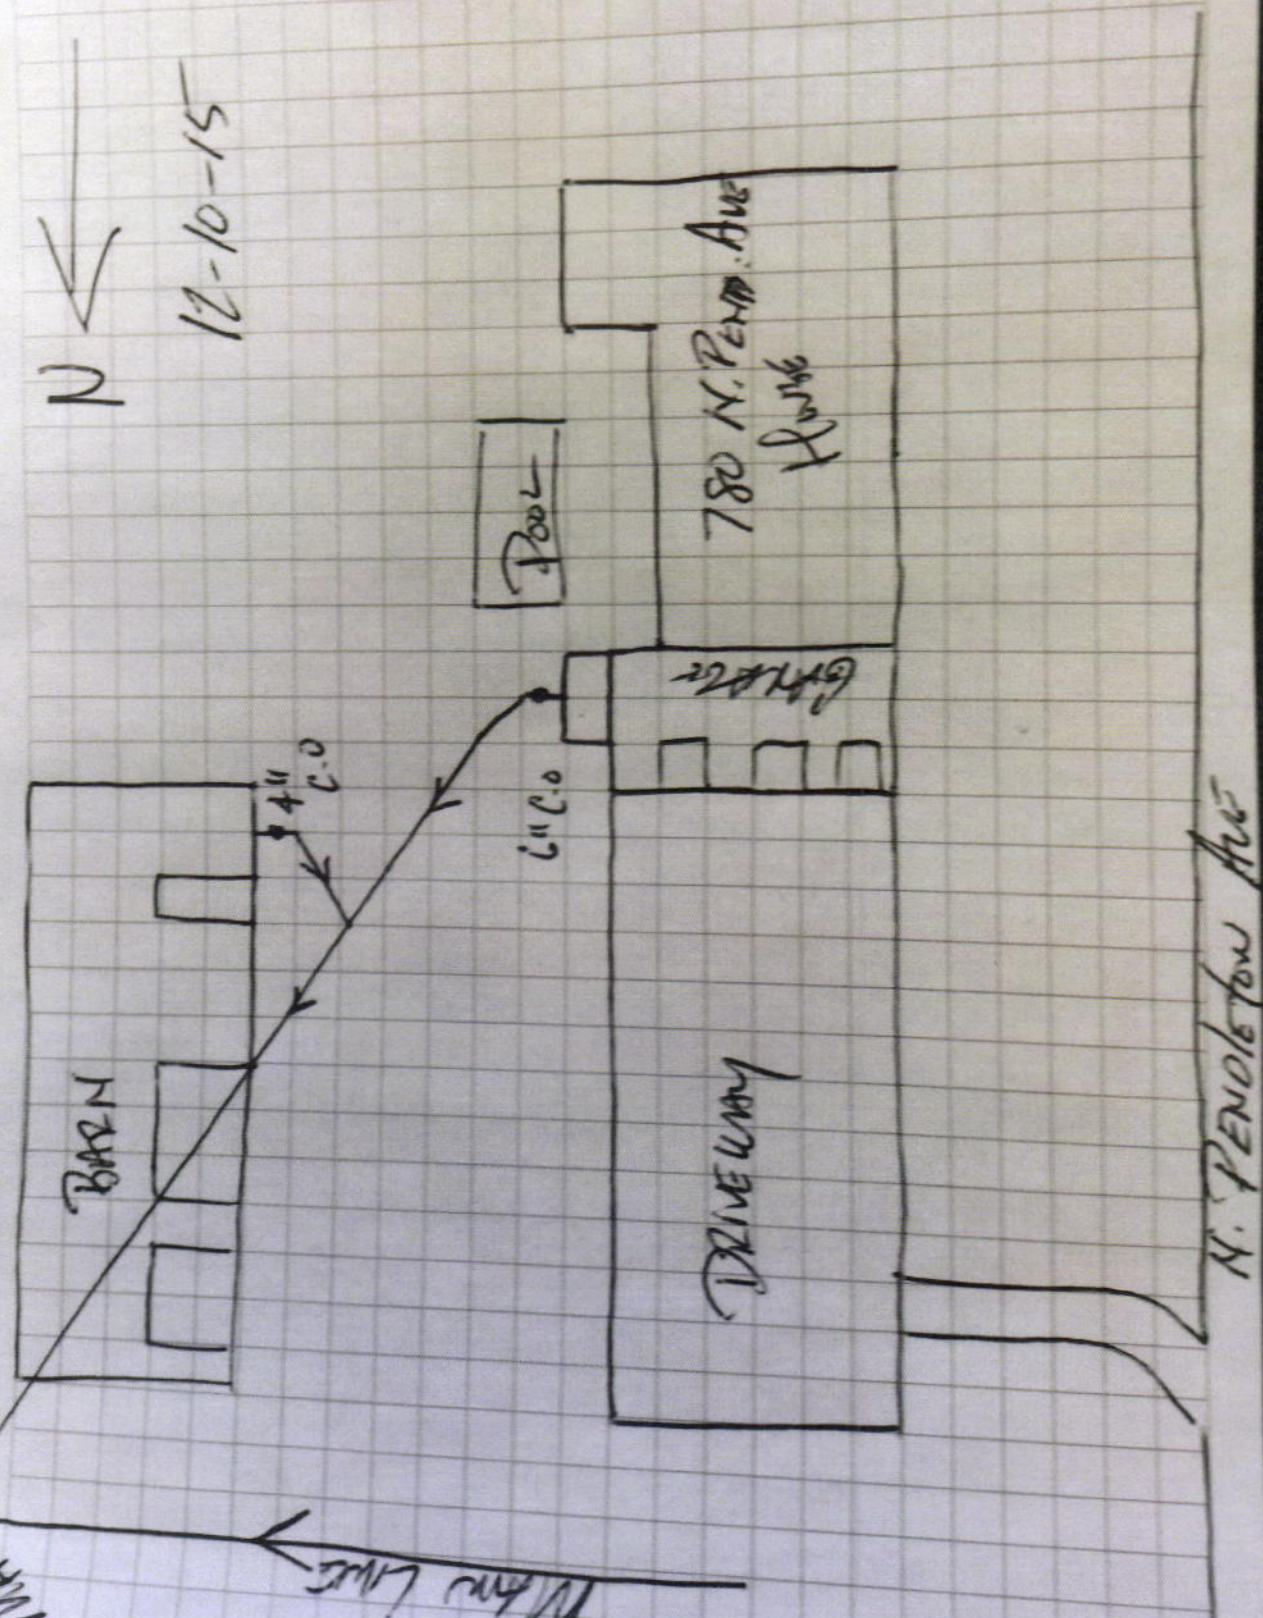



**ROBERT G. TAYLOR, INC.**  
8880 SOUTH CR. 800 WEST  
DALEVILLE, INDIANA 47334



71-65/749

**009211**  
NUMBER

00009211

PAY:

SEVEN THOUSAND NINE HUNDRED FIVE AND XX / ~~100~~ <sup>100</sup> Dollars

AMOUNT

10/23/02 \*\*\*\*\*\$7,905.00

TO THE  
ORDER  
OF

Fall Creek Regional Waste Dist  
P.O. Box 59  
Pendleton, IN 46064

ROBERT G. TAYLOR, INC.

*Cindy L. Cottonson*

THIS DOCUMENT CONTAINS HEAT SENSITIVE INK. TOUCH OR PRESS HERE - RED IMAGE DISAPPEARS WITH HEAT

0009211

780 N Pendleton Avenue  
lot 139, Fiddlers Green  
lot 143, Fiddlers Green