


Mike & Jan Heavin
Waste District #6578

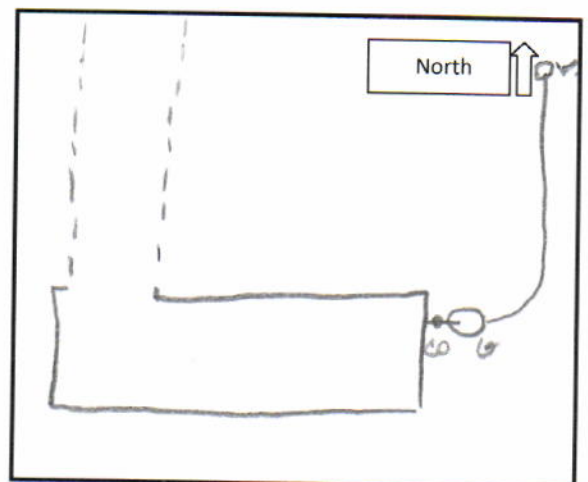

2 pictures attached


7815 W 1050 S

10-11-16



7815 W 1090 S

10.11.14

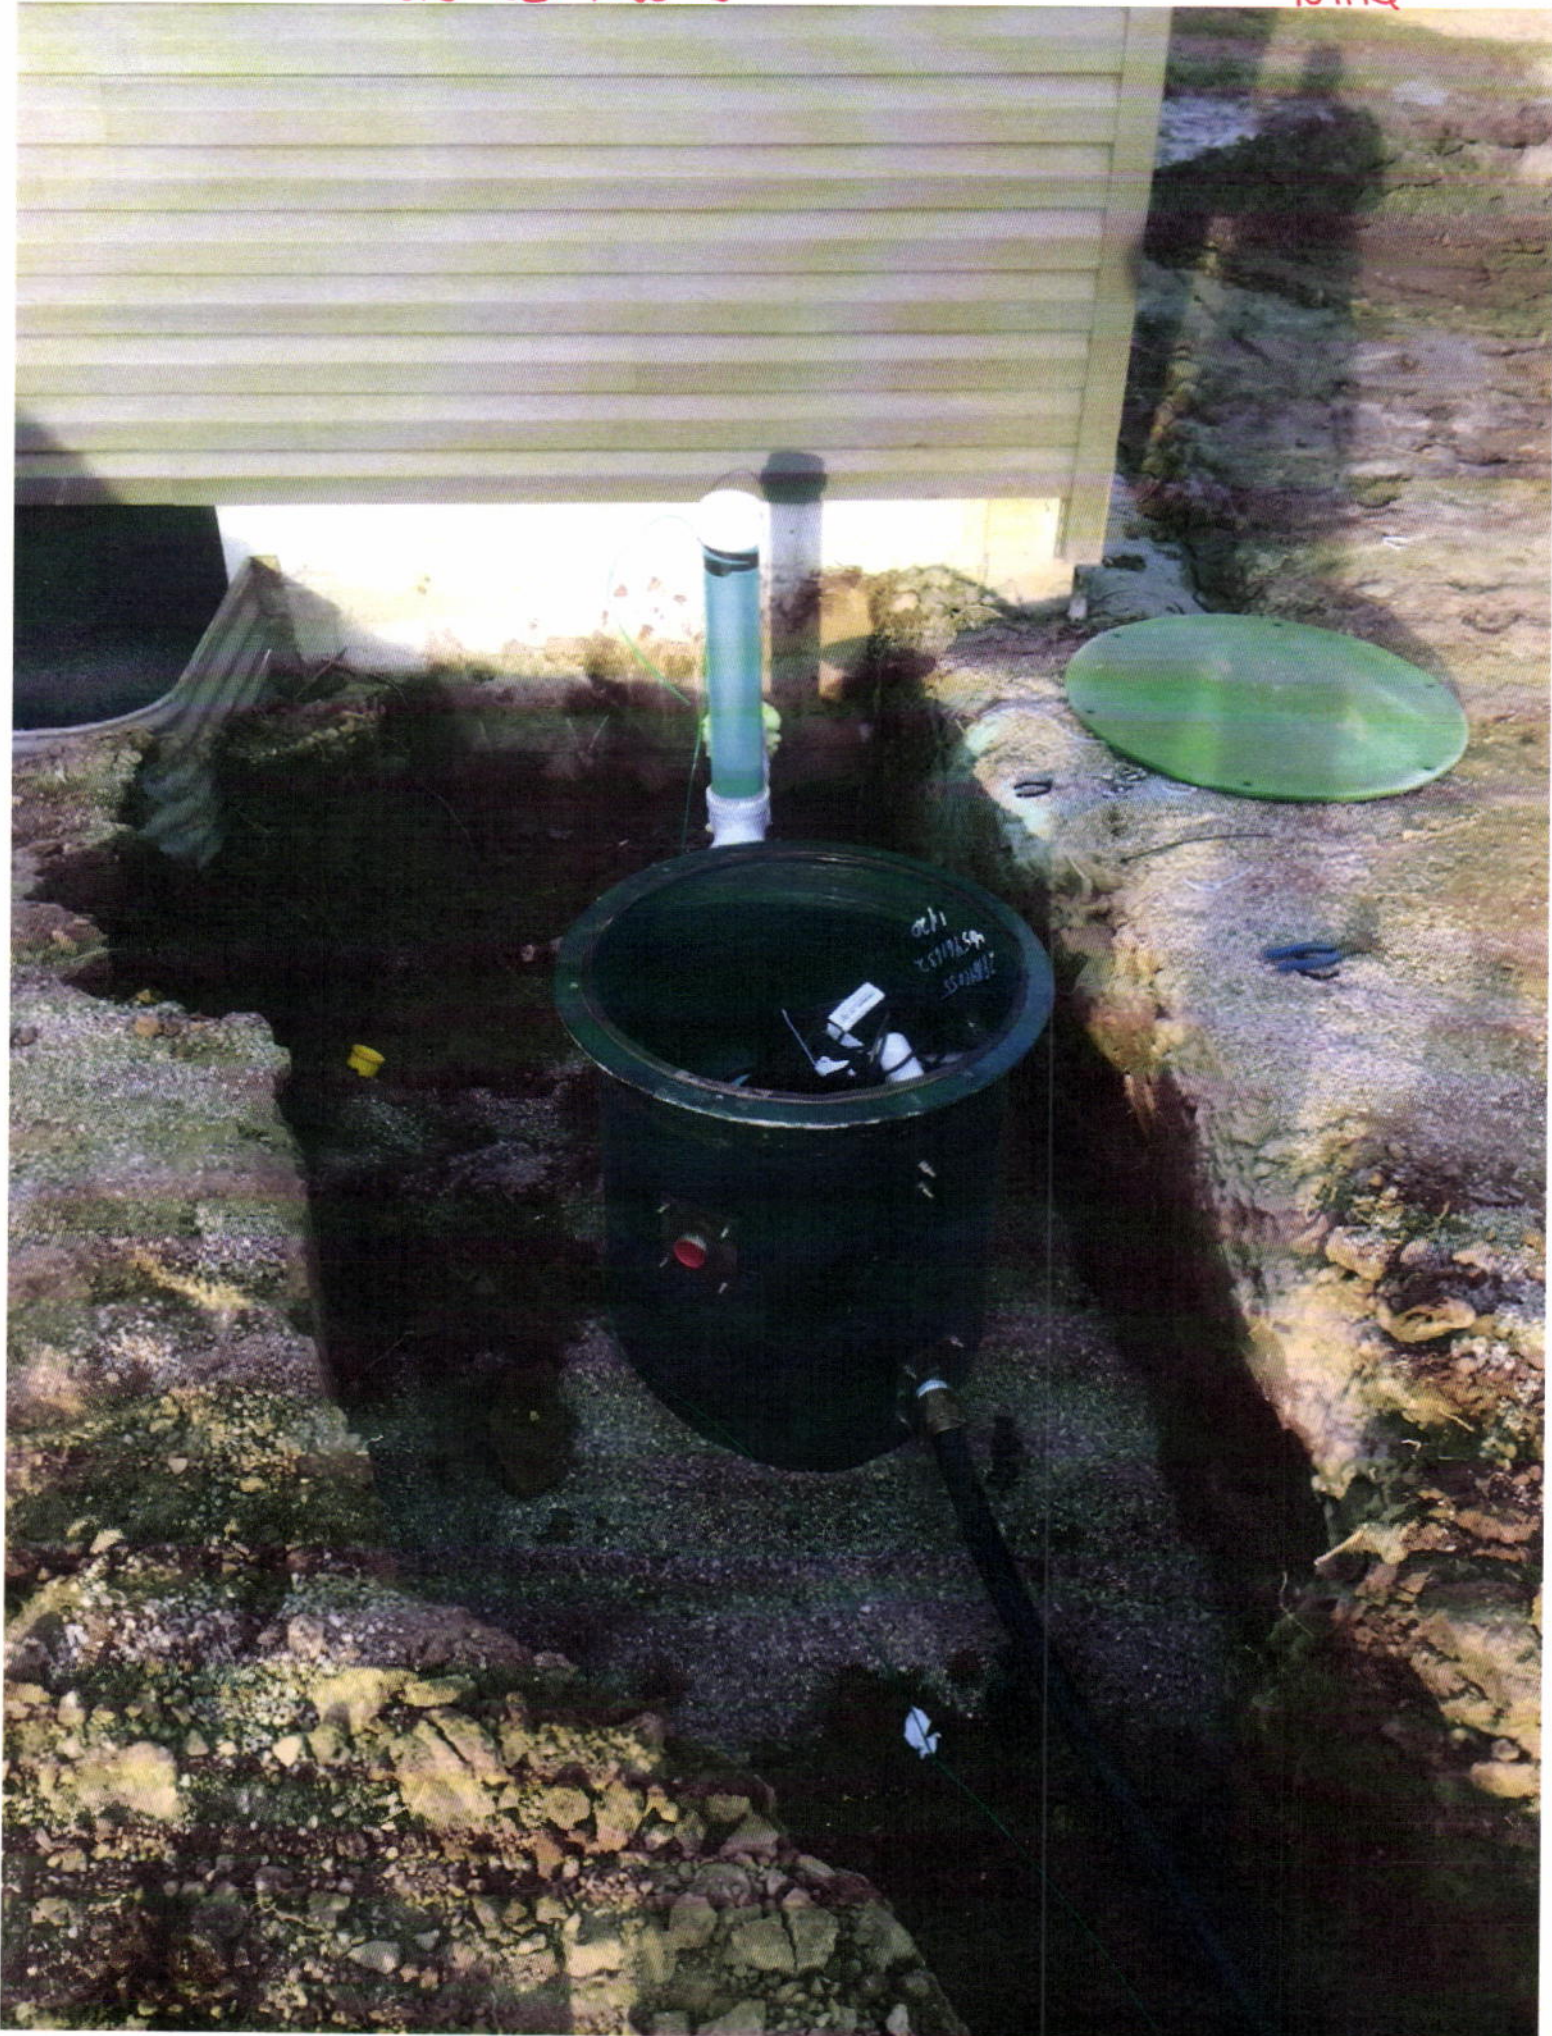



REDBUD ESTATES SALES, INC.
1800 WEST 38TH STREET
ANDERSON, IN 46013

STAR FINANCIAL BANK
71-167749

21697
FRAUDARMOR

DATE

AMOUNT

\$ 5,841.70

PAY
TO THE
ORDER
OF:

Five Thousand Eight Hundred Forty One & 70/100
Fall Creek Regional Woods



AUTHORIZED SIGNATURE

Receipt # 010492

Michael C. Jank
hasvin.

Talked to Teddy
@ Redbud
12.20.11