

21290
21-21290 #6423

Fall Creek Regional Waste District

9378 S 650 W, P.O. Box 59, Pendleton, IN 46064
765-778-7544

Agreement for Sanitary Sewer Service

This Agreement made and entered into this 14 day of June, 2011, between Fall Creek Regional Waste District ("District") and Paul Chapman Builder ("Applicant") regarding the provision of sanitary sewer service, and the assignment of capacity in and connection to, the District's facilities for the premises located at PH Lot 239 7825 Rose Lane

Now therefore, the parties, in consideration of the mutual promises set out in this Agreement, the receipt and sufficiency of which is hereby acknowledged, agree as follows:

1. The Applicant agrees that all workmanship and materials shall conform to all District ordinances and the District's construction standards. District must accept and approve all work and materials before backfilling and final connection is made to the sewer mains. Any violation of this provision will cause all lines and appurtenances in violation to be removed and replaced at the Applicant's expense.
2. The District shall have the right to enter upon the Applicant's premises at all reasonable times to inspect, repair, or replace any equipment used in connection with the District's service or which has an impact on said service.
3. The Applicant shall be responsible for all monthly user rates, capacity charges, and tap fees. The failure to pay any rate charge or fee may result in a lien against the property and/or the termination of service to the property, the cost of which will be borne by Applicant, including, but not limited to, all attorney's fees and collection costs.
4. The District shall not be responsible for any damages as a result of any failure to supply service unless said damages are due to default, neglect or culpability on the part of the District.
5. If there is an available sanitary sewer within three hundred (300) feet of the property line, the property owner shall be required to connect to the District's sanitary sewer system.
6. The Applicant and District agree that the provision of sanitary sewer service touches and concerns the property and the terms of this Agreement bind the District and Applicant and their heirs, executors, administrators, personal representatives, successors, agents, attorneys, assigns, designees, and transferees.

The parties hereto have read and fully understand the above provisions and agree to comply with said provisions.

FALL CREEK REGIONAL WASTE DISTRICT

Rebecca Lynn Hunter
Signature

APPLICANT

Paul Chapman
Signature

STATE OF INDIANA)
) SS:
COUNTY OF MADISON)

SUBSCRIBED and sworn to before me this 14 day of June, 2011

My Commission Expires:



Commission Expires November 20, 2015
A Resident of
Hamilton County, Indiana
Rebecca Lynn Hunter, Notary Public

Signature

Rebecca Lynn Hunter

Printed

Rebecca Lynn Hunter

Notary Public

Resident of Hamilton County

Inspector SN Date Inspected 6/24/11 Approved ✓ Rejected _____

Reason for Rejection _____

Date Reinspected _____ Approved _____ Rejected _____

Notes:

Size Pipe 6" Type Pipe 35

Basement Yes _____ No _____

Sump Pump Yes _____ No _____

Downspout to Ground Yes _____ No _____


Septic Tank Pumped & Filled Yes _____ No _____

Contractor ATKINS EX.

Special Conditions _____

Existing Home _____

New Construction ✓

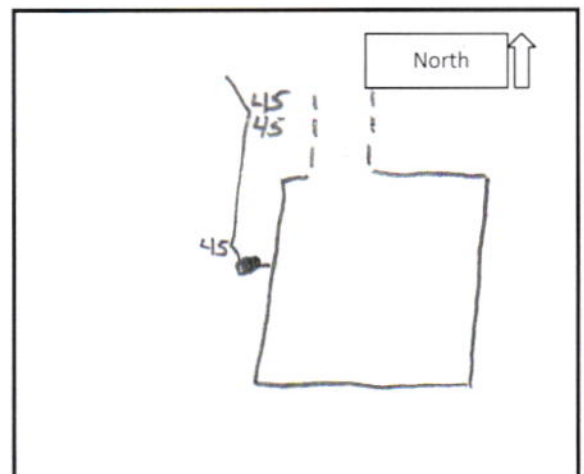

CONFIDENTIAL

COPY

PAUL SHOOPMAN HOME BUILDING GROUP, INC.

6500 TECHNOLOGY CENTER DRIVE SUITE 100
INDIANAPOLIS, IN 46278
PH. 317-733-9810



THE NATIONAL
BANK OF AMERICA
Our City. Your Bank.

20-667-740

E2Shield™ Check Fraud
Protection for Business

DATE

6/1/11

AMOUNT

\$3,370.00

11459

PAY
TO THE
ORDER
OF

Fall Creek Regional Waste District

Three Thousand Three Hundred Seventy ⁰⁰/₁₀₀

[Signature]
AUTHORIZED SIGNATURE

⑈011459⑈