
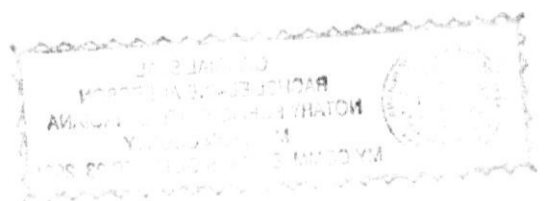


#6801

This Agreement made and entered into this 21 day of March, 2019, between Fall Creek Regional Waste District ("District") and Hallmark Homes ("Applicant") regarding the provision of sanitary sewer service, and the assignment of capacity in and connection to, the District's facilities for the premises located at _____.


North 

Drawing
+
4 pictures
attached



783 N Pendleton Ave.

N
↑

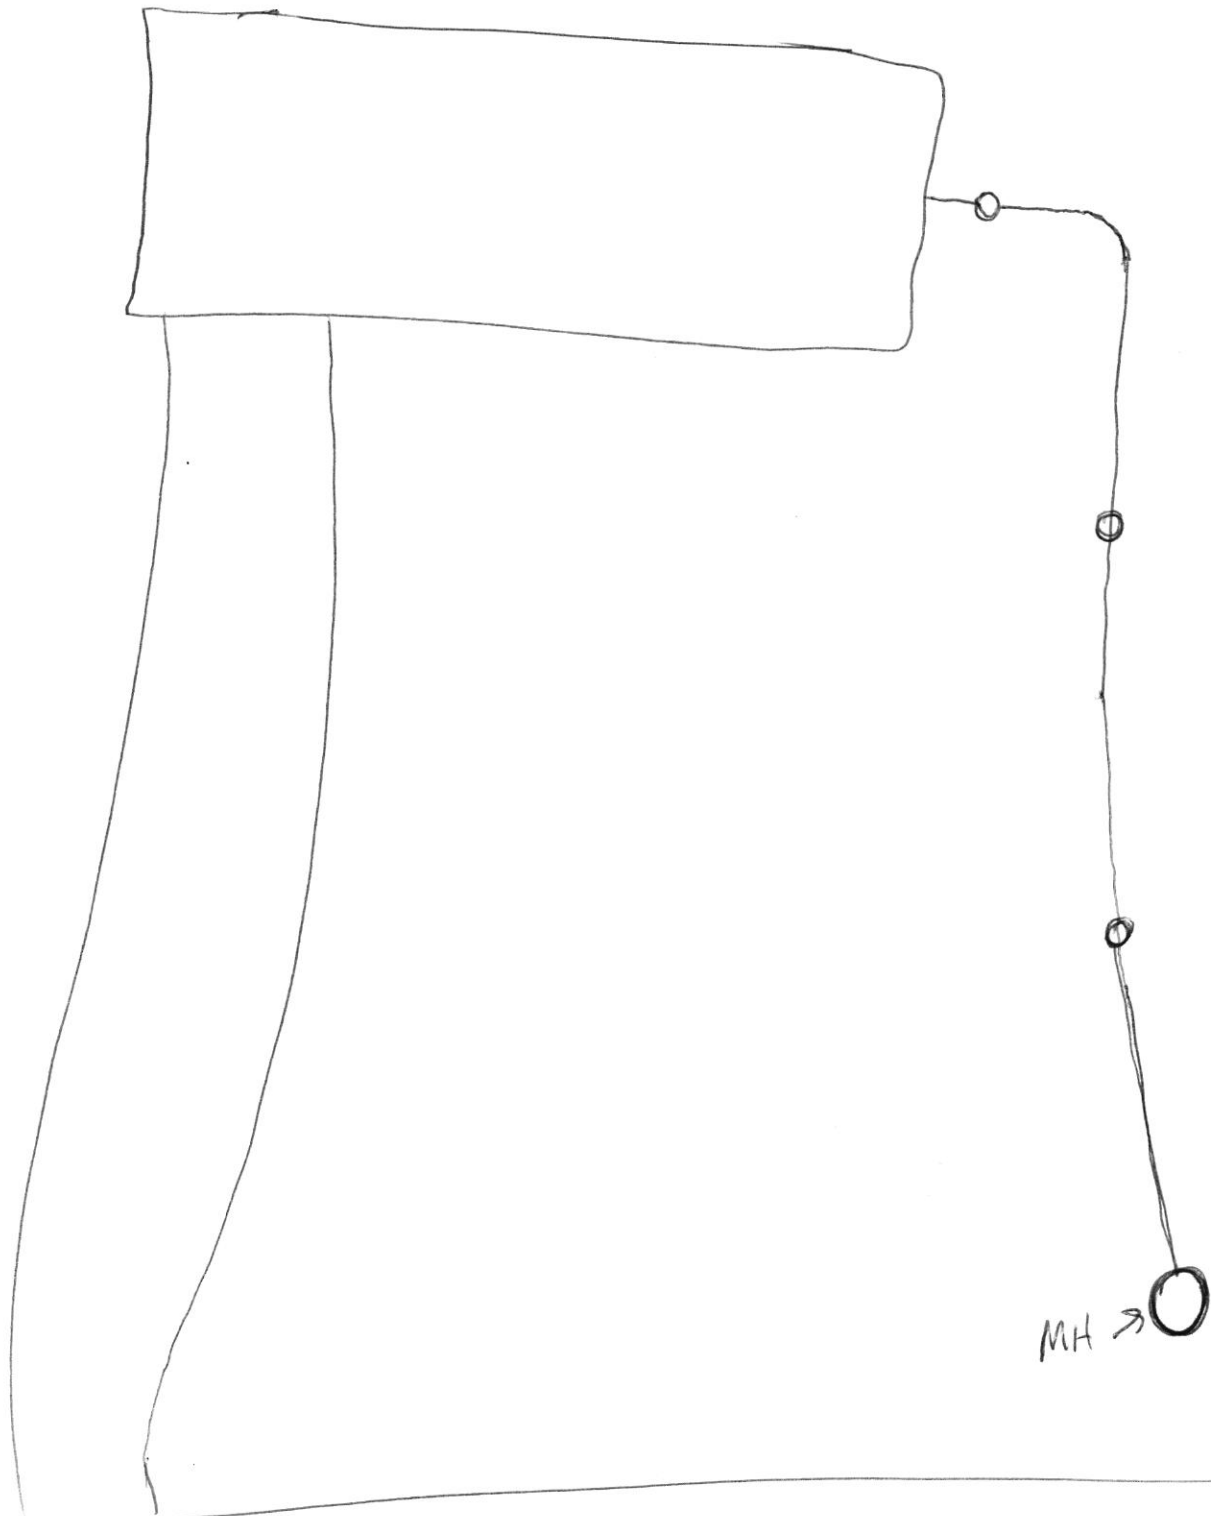

MH →









HALLMARK HOMES, INC.

433 E. 53RD SREET
ANDERSON, IN 46013
765-644-6566

Star Financial Bank
Indianapolis, IN 46255
71-1677749
71-1677749

133254

03/21/2019

PAY TO THE
ORDER OF

Fall Creek Regional Waste District

\$**3,370.00

Three thousand three hundred seventy and 00/100*****

DOLLARS

Fall Creek Regional Waste District
9378 S 650 W
PO Box 59
Pendleton, IN 460640059

MEMO

Ambrosia Ditz
AUTHORIZED SIGNATURE

Rec # 010904

Photo Safe Deposit®
Details on Back.