

add draw
on file



FALL CREEK REGIONAL WASTE DISTRICT

9378 S. 650 West PO Box 59
Pendleton, IN 46064-0059 778-7544 26-06170.00

Contractor Ron Beaver

No 2995

APPLICATION FOR SEWER PERMIT

Date 1-18-01

Permit Void 90 days from Date of Issuance

Owner Name Clayton Danford

Property Address 7878 W 1050 S

Lot # _____ P.O. Box _____

Town Fortville, IN Zip Code 46040

Phone _____ City Water _____ Well ☒

\$ N/A Tap on Fee Paid

\$ N/A Inspection fee paid

Application is hereby made for connection to the Fall Creek Regional Waste District Sewer System for the above listed property - Permit Type: Residential ☒, Commercial _____, Industrial _____, or Governmental/Institutional _____. User Information _____.

All workmanship and materials shall conform to the standards of the District Ordinance as described in Ordinance 84-2 and 84-3 as amended. Acceptance and approval must be made by the District inspector or his duly authorized representative before backfilling and final connection is made to the main sewer lines. Any violation of applicable regulations will cause all lines and appurtenances in violation to be removed and replaced at the owners expense.

The Fall Creek Regional Waste District is responsible for the inspection, approval of materials, and installation techniques only. All costs for materials and installation and any liabilities resulting from same is the sole responsibility of the property owner.

I have read and fully understand the above provisions and agree to comply by said provisions.

APPLICANT(S) SIGNATURE

INSPECTOR B. Fin

Date inspected 1-18-1 Approved ☒ Rejected _____

Reason for rejection _____


Date reinspected _____ Approved _____ Rejected _____

Notes:
Size Pipe 4"
Type Pipe PVC
Basement Yes _____ No ☒
Sump Pump Yes _____ No ☒
Downspout to Ground Yes ☒ No _____
Septic Tank Pumped & filled Yes ☒ No _____
Contractor BEAVER Septic + Sewer
Special Conditions _____

Existing Home ☒

New Construction _____

CONTRACTOR used existing 4"
Also had to change outlet

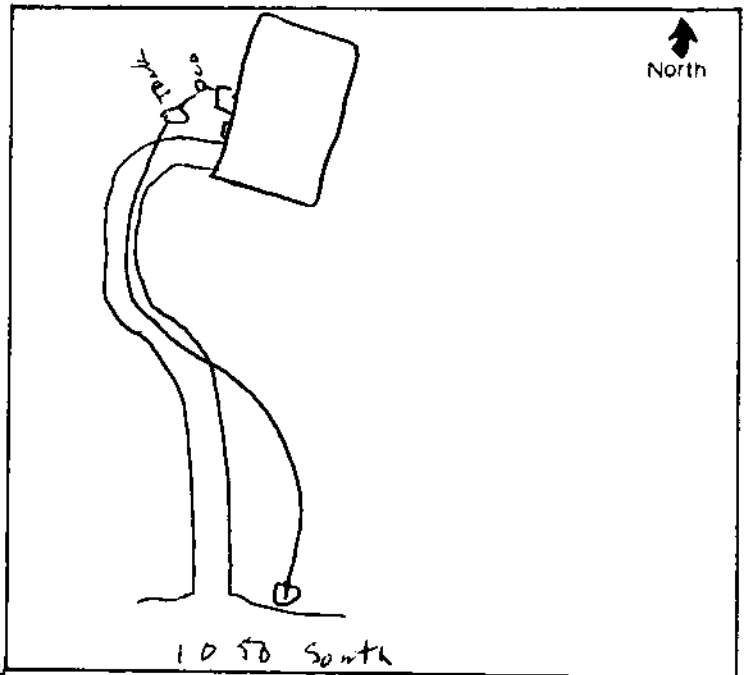

Rev 11/84 Fitting will call when complete
Tried to replace 1-19-1 could not remove B