

26-01645.00

4651

FALL CREEK REGIONAL WASTE DISTRICT

9378 S 650 WEST, P.O. BOX 59, PENDLETON, IN 46064

765-778-7544

AGREEMENT FOR SANITARY SEWER SERVICE

This Agreement made and entered into this 25th day of Sept, 2002, between FALL CREEK REGIONAL WASTE DISTRICT ("District") and Charles Adams ("Applicant") regarding the provision of sanitary sewer service, and the assignment of capacity in, and connection to, the District's facilities for the premises located at 800 Red Oak Lane.

NOW THEREFORE, the parties, in consideration of the mutual promises set out in this Agreement, the receipt and sufficiency of which is hereby acknowledged, agree as follows:

1. The Applicant agrees that all workmanship and materials shall conform to all District ordinances and standards. District must accept and approve all work and materials before backfilling and final inspection. Any violation of this provision will cause all lines and appurtenances in violation to be replaced at Applicant's expense.

Put in
Donnies
mailbox
9-26-02

District has the right to enter upon the Applicant's premises at all reasonable times to inspect and maintain equipment used in connection with the District's service or which has an impact on said service.

Applicant shall be responsible for all monthly user rates, capacity charges, and tap fees. The failure to pay any rate or fee may result in a lien against the property and/or the termination of service to the property, the cost of which will be borne by Applicant, including, but not limited to, all attorney's fees and collection costs.

4. The District shall not be responsible for any damages as a result of any failure to supply service unless said damages are due to default, neglect or culpability on the part of the District.

5. If there is an available sanitary sewer within three hundred (300) feet of the property line, the property owner shall be required to connect to the District's sanitary sewer system.

6. The Applicant and District agree that the provision of sanitary sewer service touches and concerns the property and the terms of this Agreement bind the District and Applicant and their heirs, executors, administrators, personal representatives, successors, agents, attorneys, assigns, designees, and transferees.

The parties hereto have read and fully understand the above provisions and agree to comply with said provisions.

FALL CREEK REGIONAL WASTE DISTRICT

Signature

APPLICANT

Signature

STATE OF INDIANA)

) SS:

COUNTY OF MADISON)

SUBSCRIBED and sworn to before me this 25th day of September, 2002.

My Commission Expires:

4-29-09

Signature

Printed

Notary Public

Resident of Madison County

INSPECTOR Steve DATE INSPECTED 9/24/02 APPROVED ✓ REJECTED _____

REASON FOR REJECTION _____

DATE REINSPECTED _____ APPROVED _____ REJECTED _____

NOTES:

SIZE PIPE 4" 1/2 TYPE PIPE 35 160

BASEMENT YES NO

SUMP PUMP YES NO

DOWNSPOUT TO GROUND YES NO


SEPTIC TANK PUMPED & FILLED YES NO

CONTRACTOR Long & Kofur

SPECIAL CONDITIONS _____

EXISTING HOME ✓

NEW CONSTRUCTION _____

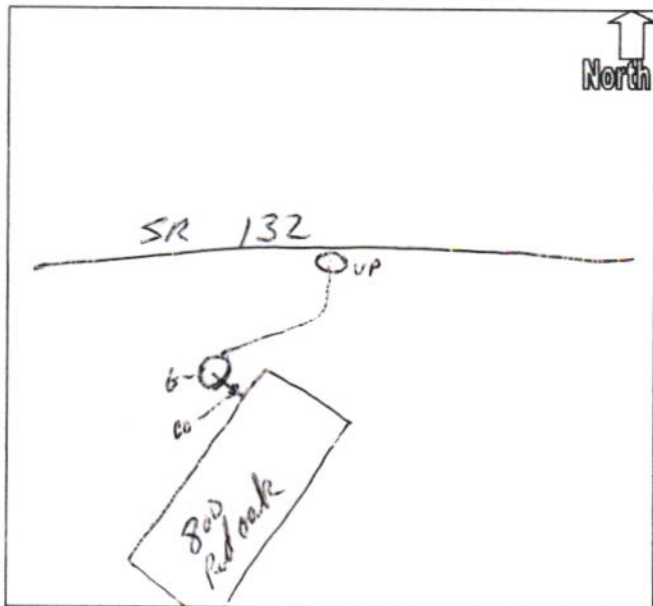

LONG & KOFFER, INC.
1795 W. HUNTSVILLE RD.
PENDLETON, INDIANA 46064
765/778-5219

NATIONAL CITY BANK OF INDIANA
INDIANAPOLIS, INDIANA 46255
20-6/740

1734

9/24/2002

PAY TO THE
ORDER OF

Fall Creek Regional Waste District


\$ **1,024.80

One Thousand Twenty-Four and 80/100*****

DOLLARS

Fall Creek Regional Waste District

MEMO:

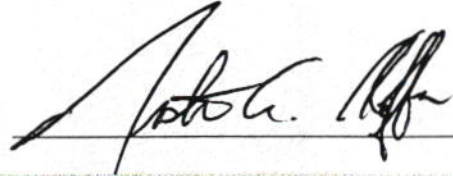

⑈001734⑈ ⑆074000065⑆

SECURITY FEATURES: MICRO PRINT TOP & BOTTOM BORDERS - COLORED PATTERN - ARTIFICIAL WATERMARK ON REVERSE SIDE - MISSING FEATURE INDICATES A COPY

CHARLES J ADAMS
PO BOX 232
PENDLETON IN 46064

71-65/749

Date 25 SEP 2002

PAY TO THE
ORDER OF

FCRWD

\$ 2635⁰⁰

TWO THOUSAND-THIRTY-FIVE ⁰⁰/₁₀₀₀ DOLLARS



Madison
Community Bank

MEMO

F326

Charles J Adams

⑆074905539⑆