

add order
on file



FALL CREEK REGIONAL WASTE DISTRICT

9378 S. 650 West PO Box 59
Pendleton, IN 46064-0059 778-7544 10-24587.00

APPLICATION FOR SEWER PERMIT

Nº 2466

Date 7/24/97

Permit Void 90 days from Date of Issuance

Owner Name Tim Ryan

Property Address 8049 S 300 W

Lot # P.O. Box

Town Pendleton, IN Zip Code 46064

Phone City Water Well ☒

\$ 400.00 Tap on Fee Paid 12/2/97 \$ 1764.20 Excess L.I.W. pd 12/2/97
\$ 1900.00 capacity inspection fee paid 12/2/97

Application is hereby made for connection to the Fall Creek Regional Waste District Sewer System for the above listed property - Permit Type: Residential ☒, Commercial ☐, Industrial ☐, or Governmental/Institutional ☐. User Information

All workmanship and materials shall conform to the standards of the District Ordinance as described in Ordinance 84-2 and 84-3 as amended. Acceptance and approval must be made by the District inspector or his duly authorized representative before backfilling and final connection is made to the main sewer lines. Any violation of applicable regulations will cause all lines and appurtenances in violation to be removed and replaced at the owners expense.

The Fall Creek Regional Waste District is responsible for the inspection, approval of materials, and installation techniques only. All costs for materials and installation and any liabilities resulting from same is the sole responsibility of the property owner.

I have read and fully understand the above provisions and agree to comply by said provisions.

APPLICANT(S) SIGNATURE


INSPECTOR

Date inspected 7-23-97 Approved ☒ Rejected ☐

Reason for rejection

Date reinspected Approved Rejected

Notes:
Size Pipe 4" "
Type Pipe PVC
Basement Yes No ☒
Sump Pump Yes No ☒
Downspout to Ground Yes ☒ No
Septic Tank Pumped & filled Yes ☒ No
Contractor M+M
Special Conditions
Existing Home ☒
New Construction

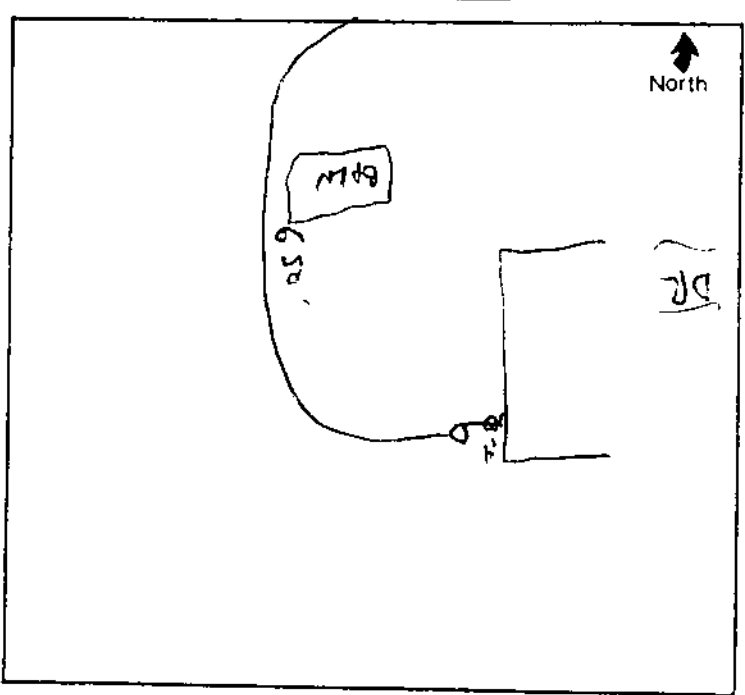



FALL CREEK REGIONAL WASTE DISTRICT

P.O. Box 59 • 9378 S. 650 West • Pendleton, Indiana 46064-0059 • (765) 778-7544

\$ 27.36
x 12 mos

\$ 328.32

x 3 yrs

\$ 984.96

Service Address: 3037 Angle Road
Pendleton, IN 46064

INVOICE

August 5, 1997

\$ 24,742.45
÷ 9
2,749.16

Pro-rated cost of construction	\$2,749.16
Less three (3) year revenue credit	- 984.96
Your cost of construction	<u>\$1,764.20</u>
Tap Fee	400.00
Capacity Fee	1,900.00
TOTAL DUE Fall Creek Regional Waste	<u>\$4,064.20</u>