

Gidw.


PROJECT Phase II SHEET _____ OF _____

SUBJECT _____ DATE 6-18-18

JOB NO 4447

BY Atlas

805 S. Pendleton

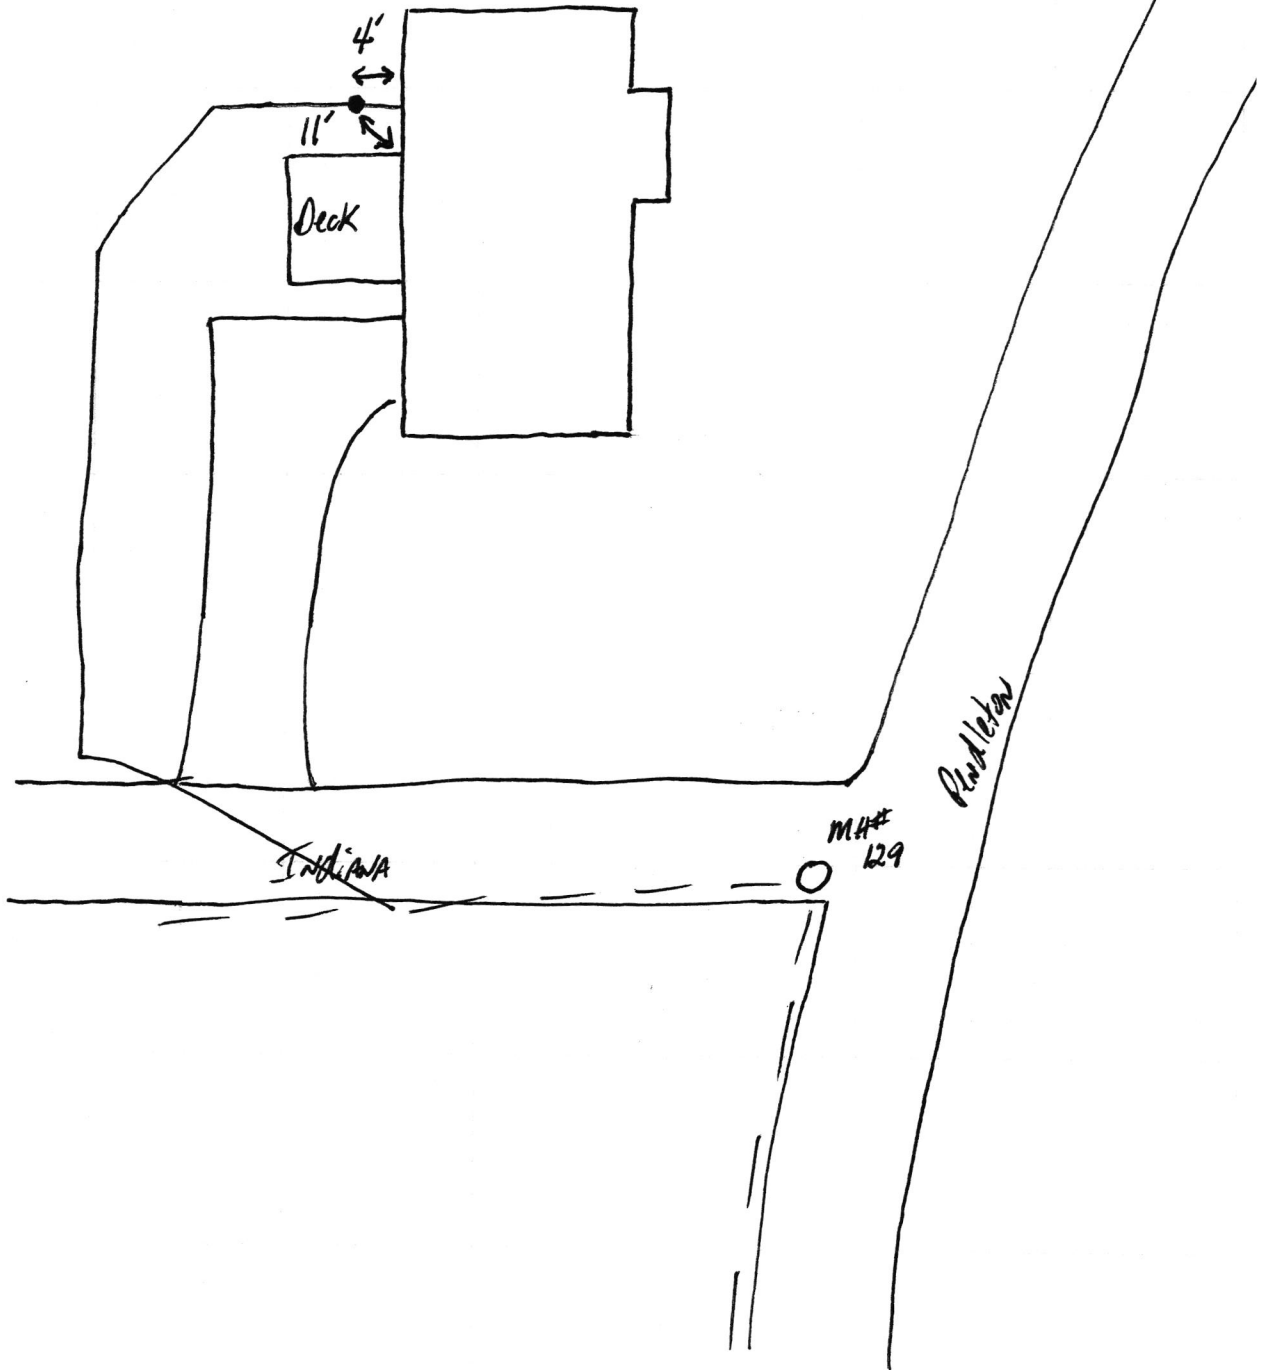

805 S Pendleton Ave

SRF Phase II

6.19.18

