

*GLW.*

PROJECT Phase II SHEET \_\_\_\_\_ OF \_\_\_\_\_


SUBJECT \_\_\_\_\_ DATE 5-14-18

JOB NO. 4447

BY AJ/as

809 S. BROADWAY

← N

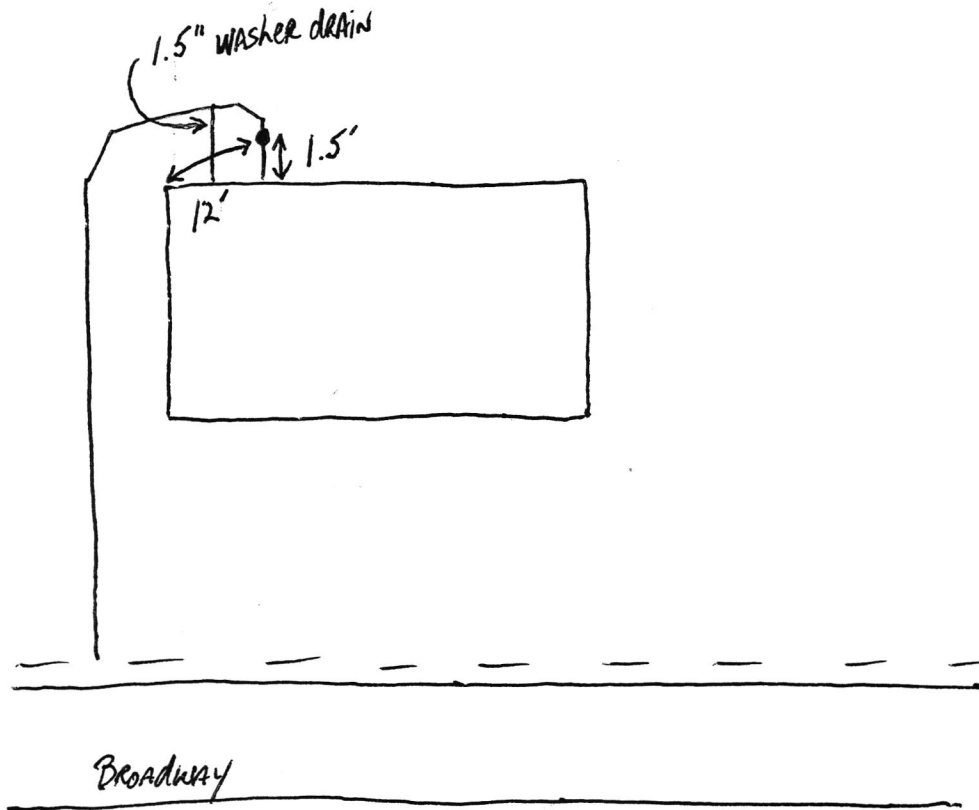



809 S Broadway

SPE Phase II

5-22-18

