


Maple Trails
8/26/21
Lot 242
8142 Dewberry Ln.
Dr. Watson

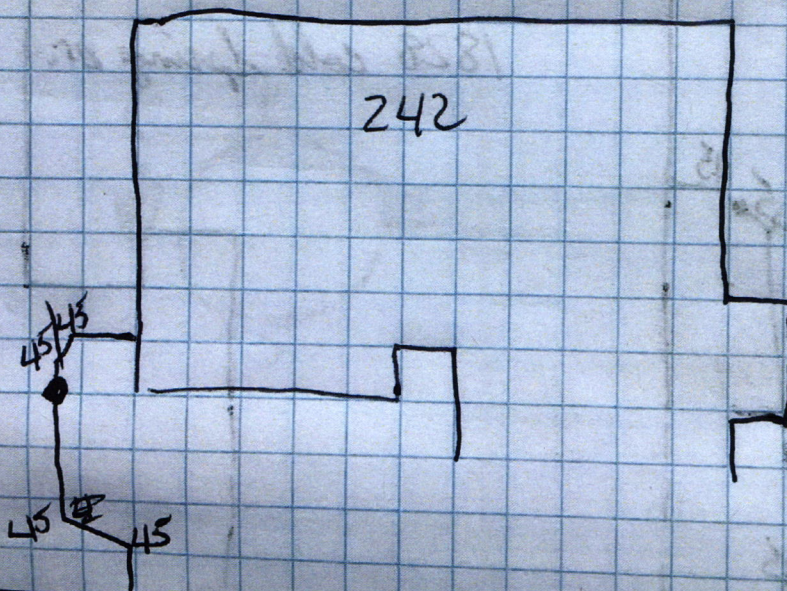

Maple Trails
Lot 85
6754 Aster Dr.
Dr. Watson



