


North

Drawing
+
1 picture
attached



5-10-24
Maple TR.
Lot 320
DR. WATSON ST.

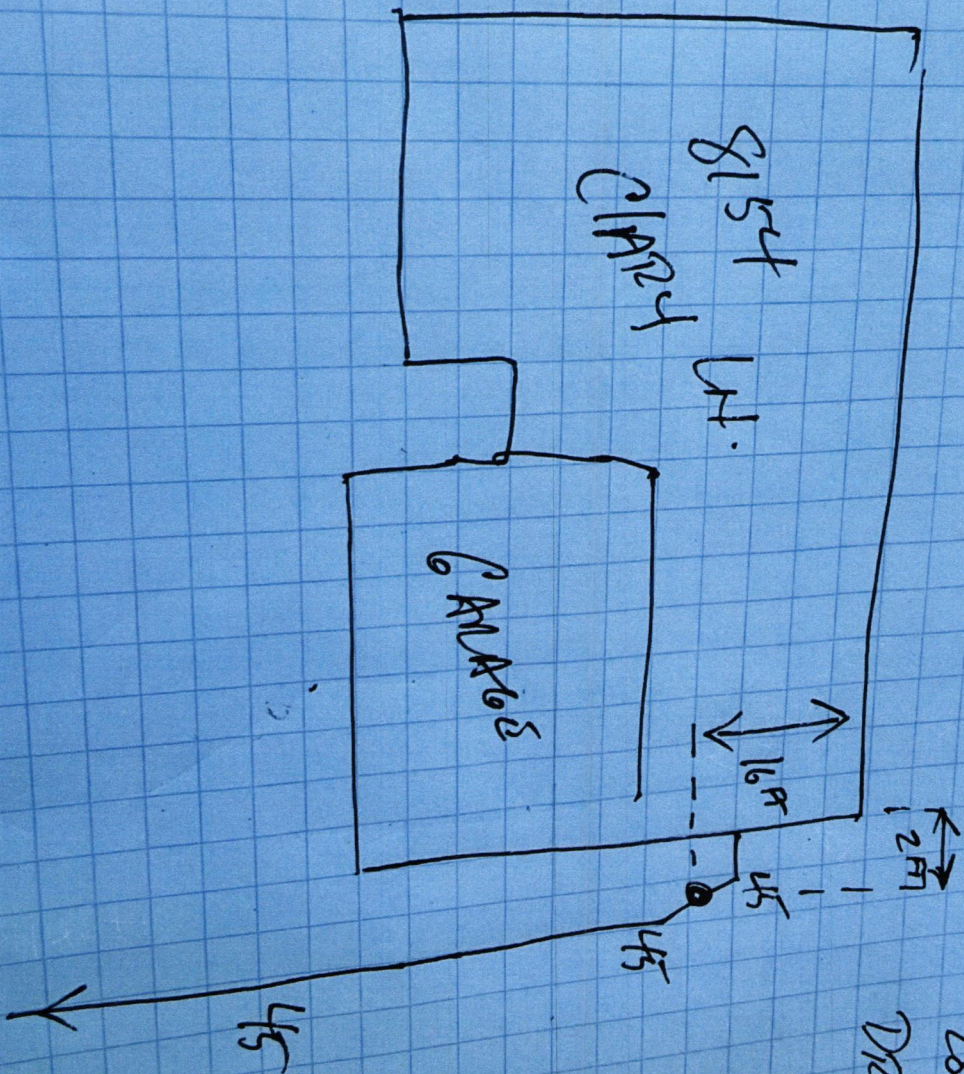