



# FALL CREEK REGIONAL WASTE DISTRICT

Box 44, Pendleton, Indiana 46064

2-0008720.00

Nº 001250

## APPLICATION FOR SEWER PERMIT

Permit No. \_\_\_\_\_ Date 1-24-86  
Permit Void 90 days from Date of Issuance  
Owner Name GARY BRAGG  
Property Address 816 SLACK DR  
Lot # \_\_\_\_\_ P.O. Box \_\_\_\_\_  
Town ANDERSON, IN Zip Code 46013  
Phone 644-7381 Water Meter \_\_\_\_\_  
\$ 150.00 Tap on Fee Paid  
\$ 25.00 Inspection fee paid

Application is hereby made for connection to the Fall Creek Regional Waste District Sewer System for the above listed property - Permit Type: Residential ☒ Commercial \_\_\_\_\_, Industrial \_\_\_\_\_, or Governmental/Institutional \_\_\_\_\_. User Information \_\_\_\_\_.

All workmanship and materials shall conform to the standards of the District Ordinance as described in Ordinance 84-2 and 84-3 as amended. Acceptance and approval must be made by the District inspector or his duly authorized representative before backfilling and final connection is made to the main sewer lines. Any violation of applicable regulations will cause all lines and appurtenances in violation to be removed and replaced at the owners expense.

The Fall Creek Regional Waste District is responsible for the inspection, approval of materials, and installation techniques only. All costs for materials and installation and any liabilities resulting from same is the sole responsibility of the property owner.

I have read and fully understand the above provisions and agree to comply by said provisions.

Gary Bragg  
APPLICANT(S) SIGNATURE

\*\*\*\*\*

INSPECTOR B


Date inspected 2-17-86 Approved ☒ Rejected \_\_\_\_\_

Reason for rejection \_\_\_\_\_

Date reinspected \_\_\_\_\_ Approved \_\_\_\_\_ Rejected \_\_\_\_\_

### Notes:

Size Pipe 6 "  
Type Pipe PVC  
Basement Yes \_\_\_\_\_ No ☒  
Sump Pump Yes \_\_\_\_\_ No ☒  
Downspout to Ground Yes ☒ No \_\_\_\_\_  
Septic Tank Pumped & filled Yes \_\_\_\_\_ No ☒  
Contractor A+A  
Special Conditions \_\_\_\_\_

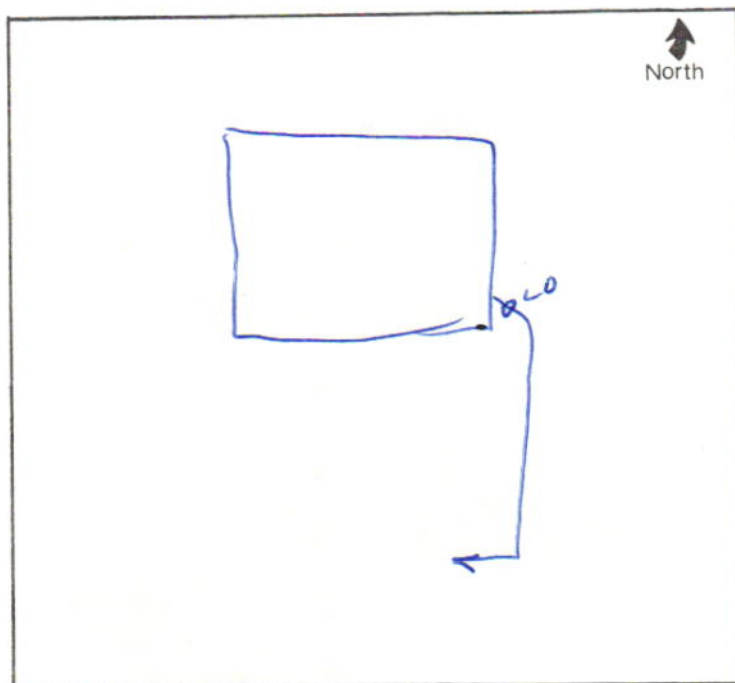

TO

Dad

TIME

1034

DATE

3-7-88

## WHILE YOU WERE OUT

M

Gary Bragg

OF

816 Slack Dr

PHONE ( )

644-7381 - around 12:30

☐ URGENT!☒ TELEPHONED☒ PLEASE CALL☐ WILL CALL AGAIN☐ CALLED TO SEE YOU☐ WANTS TO SEE YOU☐ RETURNED YOUR CALL☐ YOU'LL KNOW

MESSAGE:

line from toilet under house has let loose & waste running under house. He asked if we inspected home I told him just up to the house. He wants to know your

OPERATOR:

NOTES:

opinion whether he may have legal action against Contractor.

ADVISED DAUGHTER  
TO LHM 5

J.