


*GIS*

PROJECT Phase II SHEET \_\_\_\_\_ OF \_\_\_\_\_  
SUBJECT \_\_\_\_\_ DATE 5-15-18  
JOB NO. 4447  
BY Atlas

817 S. Broadway

← N

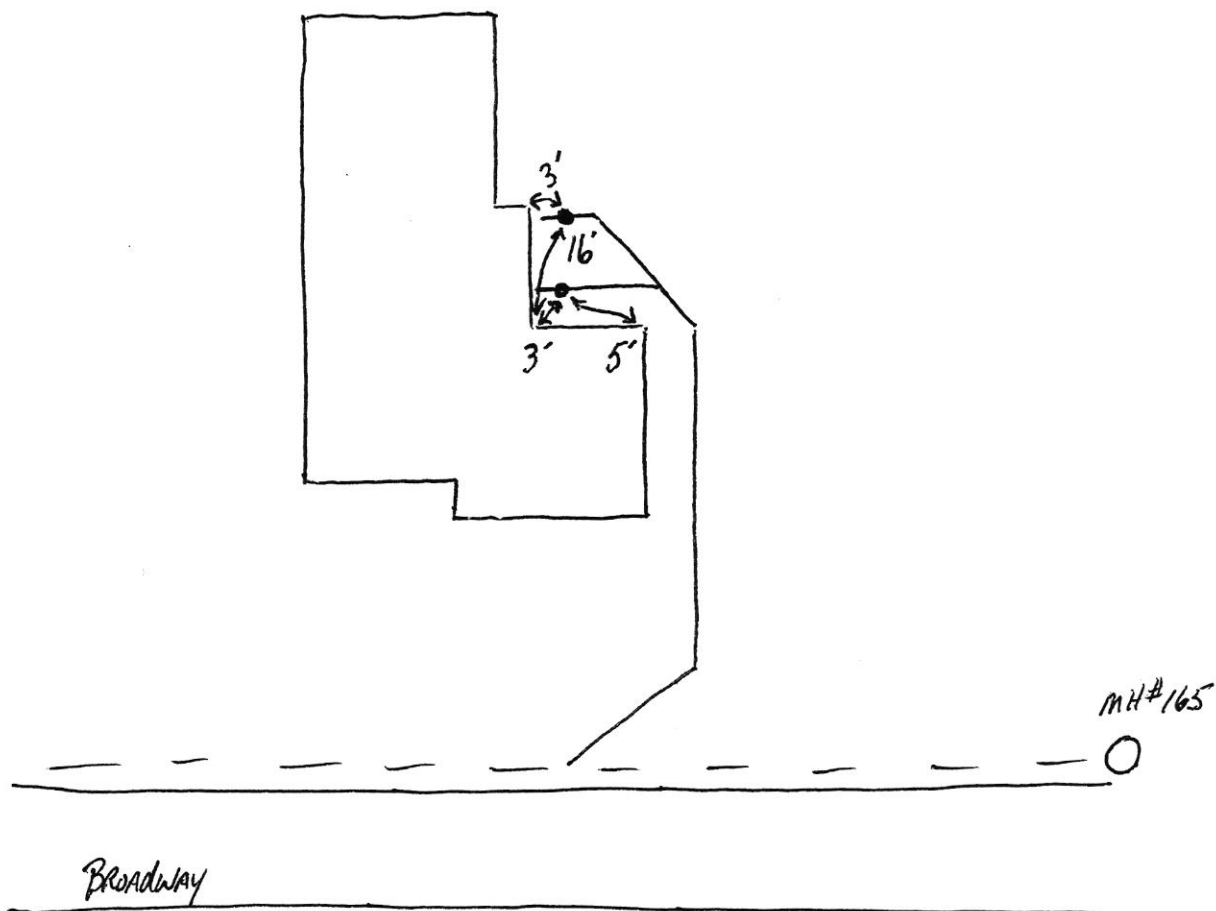

817 S Broadway

SRR Phase II

5.22.18



817 S Broadway

Self Phase II

5.22.18

