

21-06375.00

FALL CREEK REGIONAL WASTE DISTRICT

4622

9378 S 650 WEST, P.O. BOX 59, PENDLETON, IN 46064

765-778-7544

AGREEMENT FOR SANITARY SEWER SERVICE

This Agreement made and entered into this 13th day of August, 2002, between FALL CREEK REGIONAL WASTE DISTRICT ("District") and CP Morgan ("Applicant") regarding the provision of sanitary sewer service, and the assignment of capacity in, and connection to, the District's facilities for the premises located at Lot # 75 8180 S. Hedge Lane Summertime owner Christopher Werline

NOW THEREFORE, the parties, in consideration of the mutual promises set out in this Agreement, the receipt and sufficiency of which is hereby acknowledged, agree as follows:

1. The Applicant agrees that all workmanship and materials shall conform to all District ordinances and the District's construction standards. District must accept and approve all work and materials before backfilling and final connection is made to the sewer mains. Any violation of this provision will cause all lines and appurtenances in violation to be removed and replaced at the Applicant's expense.
2. The District shall have the right to enter upon the Applicant's premises at all reasonable times to inspect, repair, or replace any equipment used in connection with the District's service or which has an impact on said service.
3. The Applicant shall be responsible for all monthly user rates, capacity charges, and tap fees. The failure to pay any rate charge or fee may result in a lien against the property and/or the termination of service to the property, the cost of which will be borne by Applicant, including, but not limited to, all attorney's fees and collection costs.
4. The District shall not be responsible for any damages as a result of any failure to supply service unless said damages are due to default, neglect or culpability on the part of the District.
5. If there is an available sanitary sewer within three hundred (300) feet of the property line, the property owner shall be required to connect to the District's sanitary sewer system.
6. The Applicant and District agree that the provision of sanitary sewer service touches and concerns the property and the terms of this Agreement bind the District and Applicant and their heirs, executors, administrators, personal representatives, successors, agents, attorneys, assigns, designees, and transferees.

The parties hereto have read and fully understand the above provisions and agree to comply with said provisions.

FALL CREEK REGIONAL WASTE DISTRICT
Jan Carey
Signature

APPLICANT
Elizabeth Ware
Signature

STATE OF INDIANA)
) SS:
COUNTY OF MADISON)

SUBSCRIBED and sworn to before me this 13th day of August, 2002.

My Commission Expires:
4-29-09


Signature Jan E. Carey
Printed Jan E. Carey
Notary Public
Resident of Madison County

INSPECTOR Bar DATE INSPECTED 8-14-02 APPROVED ✓ REJECTED _____

REASON FOR REJECTION _____

DATE REINSPECTED _____ APPROVED _____ REJECTED _____

NOTES:
SIZE PIPE 6 TYPE PIPE Pvc
BASEMENT YES _____ NO X
SUMP PUMP YES _____ NO X
DOWNSPOUT TO GROUND YES X NO _____
SEPTIC TANK PUMPED & FILLED YES _____ NO NA
CONTRACTOR Buttz
SPECIAL CONDITIONS _____
EXISTING HOME _____
NEW CONSTRUCTION X

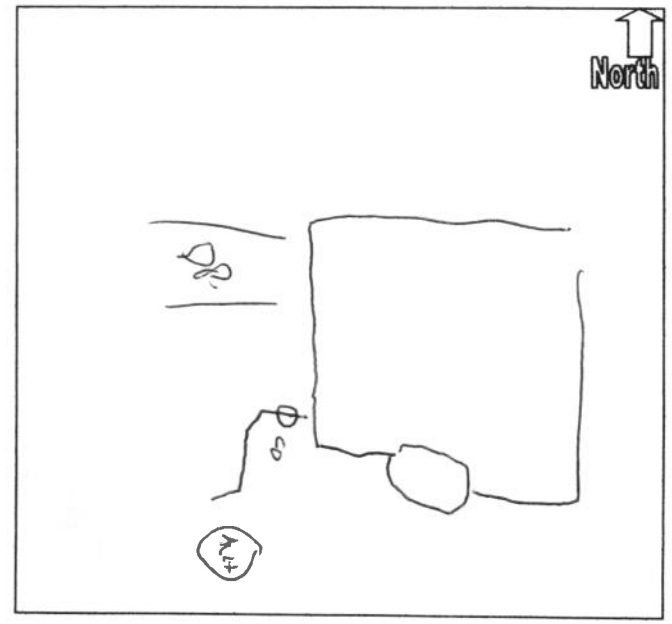

C.P. MORGAN COMMUNITIES, LP
CONSTRUCTION ACCOUNT

BANK ONE, INDIANA, NA
INDIANAPOLIS, INDIANA 46277
20-1-740

8.13.02

PAY TO THE
ORDER OF

Fall Creek Regional Waste

\$ 1,900.⁰⁰One thousand nine hundred and ⁰⁰/₁₀₀

DOLLARS

210075102

210071102

210070102

MEMO

210067102

Su 67, 70, 71, 75

Indy

⑈022629⑈ ⑆074000010⑆

705001387194⑈

M^{C.P.}MORGAN

More Square Feet. Less Money.

FAX

301 E. Carmel Dr.



Suite E-300



Carmel, Indiana



46032-2892

FAX: 317-848-2242
Office: 317-848-4040Date: 8/15/02To: Jan CareyFrom: Betsy Ware (Permit Assistant)Company: FCRWFax Number: 765-778-7545

Number of pages to follow: _____

NOTES: Summerlake buyer names

<u>Lot #</u>	<u>Buyer Name</u>
67	Jeffrey Pokonc
68	James Fuchs
70	Spec Home - No buyer
71	Robert Rodriguez
75	Christopher Werline