

FALL CREEK REGIONAL WASTE DISTRICT

9378 S 650 WEST, P.O. BOX 59, PENDLETON, IN 46064

765-778-7544

AGREEMENT FOR SANITARY SEWER SERVICE

Scott Braun

4652

21-06505-00

This Agreement made and entered into this 25th day of September, 2002, between FALL CREEK REGIONAL WASTE DISTRICT ("District") and C.P. Morgan ("Applicant") regarding the provision of sanitary sewer service, and the assignment of capacity in and connection to, the District's facilities for the premises located at 10780, 1/4 Quarter Moon Drive
8220 S

NOW THEREFORE, the parties, in consideration of the mutual promises set out in this Agreement, the receipt and sufficiency of which is hereby acknowledged, agree as follows:

1. The Applicant agrees that the District's construction standards. D connection is made to the sewer mains. to be removed and replaced at the Appli

Put in
Bens
mailbox
10-28

ll conform to all District ordinances and work and materials before backfilling and final cause all lines and appurtenances in violation

2. The District shall have the inspect, repair, or replace any equipmen service.

premises at all reasonable times to t's service or which has an impact on said

3. The Applicant shall be responsible for all monthly user rates, capacity charges, and tap fees. The failure to pay any rate charge or fee may result in a lien against the property and/or the termination of service to the property, the cost of which will be borne by Applicant, including, but not limited to, all attorney's fees and collection costs.

4. The District shall not be responsible for any damages as a result of any failure to supply service unless said damages are due to default, neglect or culpability on the part of the District.

5. If there is an available sanitary sewer within three hundred (300) feet of the property line, the property owner shall be required to connect to the District's sanitary sewer system.

6. The Applicant and District agree that the provision of sanitary sewer service touches and concerns the property and the terms of this Agreement bind the District and Applicant and their heirs, executors, administrators, personal representatives, successors, agents, attorneys, assigns, designees, and transferees.

The parties hereto have read and fully understand the above provisions and agree to comply with said provisions.

FALL CREEK REGIONAL WASTE DISTRICT

Signature

APPLICANT

Signature

STATE OF INDIANA)

) SS:

COUNTY OF MADISON)

SUBSCRIBED and sworn to before me this 25th day of September, 2002.

My Commission Expires:

4-29-02

Signature

Printed

Notary Public

Resident of Madison County

INSPECTOR B DATE INSPECTED 11-28-02 APPROVED ✓ REJECTED

REASON FOR REJECTION

DATE REINSPECTED

APPROVED

REJECTED

NOTES:

SIZE PIPE 6 TYPE PIPE PVC

BASEMENT YES NO X

SUMP PUMP YES NO X

DOWNSPOUT TO GROUND YES X NO


SEPTIC TANK PUMPED & FILLED YES NO X

CONTRACTOR Butty

SPECIAL CONDITIONS

EXISTING HOME

NEW CONSTRUCTION X

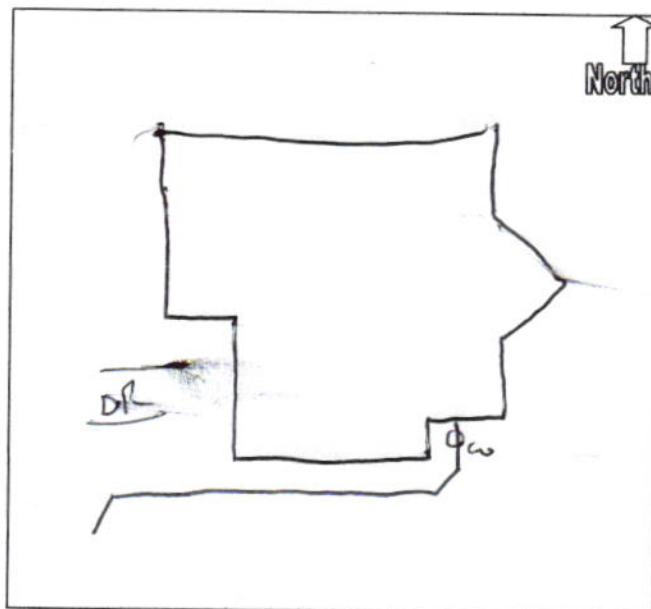

C.P. MORGAN COMMUNITIES, LP
CONSTRUCTION ACCOUNT

BANK ONE, INDIANA, NA
INDIANAPOLIS, INDIANA 46277
20-1-740

23276

9.25

PAY TO THE
ORDER OF

Fall Creek Regional Waste Dist

\$6175.00

Six thousand one hundred + seventy-five dollars ⁰⁰/₁₀₀ DOLLARS

SU - 85, 31, 80, 143, 96, 148

MEMO SU - 100, 90, 98, 149, 174, 135, 140, 97

⑈023276⑈ ⑈074000010⑈

Jennifer Hedges ^{MP}