

9/9176.00



FALL CREEK REGIONAL WASTE DISTRICT

Box 44, Pendleton, Indiana 46064

3-091976

Nº 000172

APPLICATION FOR SEWER PERMIT

Permit No. _____ Date 9-12-85
 Permit Void 90 days from Date of Issuance
 Owner Name Carolyn Lennie
 Property Address RR 2 826 S. Pendleton Ave.
 Lot # _____ P.O. Box 14
 Town Pendleton, IN Zip Code 46064-1354
 Phone 778-3337 Water Meter P/W "
 \$ 150.00 Tap on Fee Paid
 \$ 25.00 Inspection fee paid

Application is hereby made for connection to the Fall Creek Regional Waste District Sewer System for the above listed property - Permit Type: Residential , Commercial _____, Industrial _____, or Governmental/Institutional _____. User Information _____.

All workmanship and materials shall conform to the standards of the District Ordinance as described in Ordinance 84-2 and 84-3 as amended. Acceptance and approval must be made by the District inspector or his duly authorized representative before backfilling and final connection is made to the main sewer lines. Any violation of applicable regulations will cause all lines and appurtenances in violation to be removed and replaced at the owners expense.

The Fall Creek Regional Waste District is responsible for the inspection, approval of materials, and installation techniques only. All costs for materials and installation and any liabilities resulting from same is the sole responsibility of the property owner.

I have read and fully understand the above provisions and agree to comply by said provisions.


X Carolyn Lennie
 APPLICANT(S) SIGNATURE

INSPECTOR TIM

Date inspected 10-24-85 Approved Rejected _____
 Reason for rejection _____

Date reinspected _____ Approved _____ Rejected _____

Notes:
 Size Pipe 6"
 Type Pipe PVC
 Basement Yes _____ No
 Sump Pump Yes _____ No
 Downspout to Ground Yes No _____
 Septic Tank Pumped & filled Yes No _____
 Contractor EARL DAVIS
 Special Conditions _____

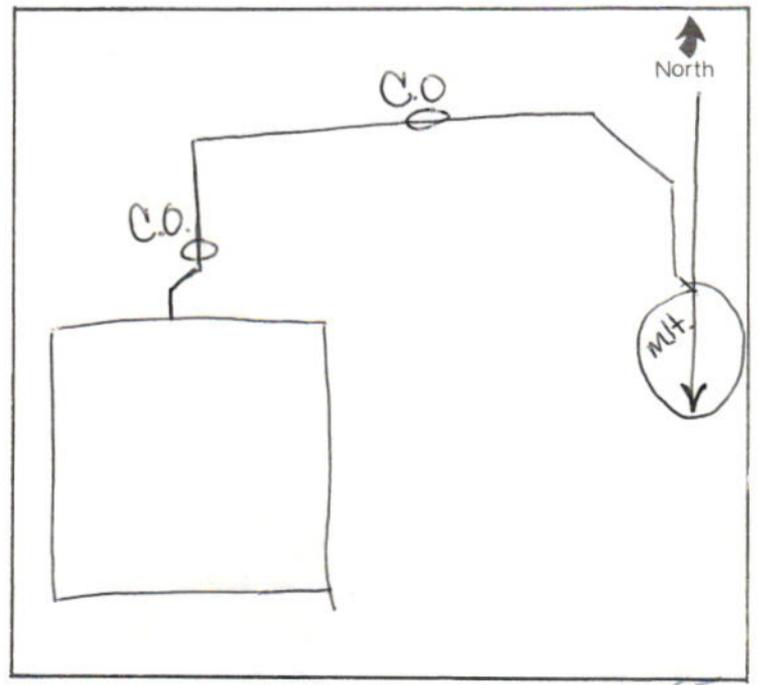

Lateral Replacement

Fall Creek Regional Waste District
9378 S 650 W, P.O. Box 59, Pendleton, IN 46064
765-778-7544

#6606

Agreement for Sanitary Sewer Service

This Agreement made and entered into this 16 day of Nov., 2016, between Fall Creek Regional Waste District ("District") and JO Dewitt ("Applicant") regarding the provision of sanitary sewer service, and the assignment of capacity in and connection to, the District's facilities for the premises located at 826 S. Pendleton Ave Pendleton, IN 46064.

Now therefore, the parties, in consideration of the mutual promises set out in this Agreement, the receipt and sufficiency of which is hereby acknowledged, agree as follows:

- 1. The Applicant agrees that all workmanship and materials shall conform to all District ordinances and the District's construction standards. District must accept and approve all work and materials before backfilling and final connection is made to the sewer mains. Any violation of this provision will cause all lines and appurtenances in violation to be removed and replaced at the Applicant's expense.
2. The District shall have the right to enter upon the Applicant's premises at all reasonable times to inspect, repair, or replace any equipment used in connection with the District's service or which has an impact on said service.
3. The Applicant shall be responsible for all monthly user rates, capacity charges, and tap fees. The failure to pay any rate charge or fee may result in a lien against the property and/or the termination of service to the property, the cost of which will be borne by Applicant, including, but not limited to, all attorney's fees and collection costs.
4. The District shall not be responsible for any damages as a result of any failure to supply service unless said damages are due to default, neglect or culpability on the part of the District.
5. If there is an available sanitary sewer within three hundred (300) feet of the property line, the property owner shall be required to connect to the District's sanitary sewer system.
6. The Applicant and District agree that the provision of sanitary sewer service touches and concerns the property and the terms of this Agreement bind the District and Applicant and their heirs, executors, administrators, personal representatives, successors, agents, attorneys, assigns, designees, and transferees.

The parties hereto have read and fully understand the above provisions and agree to comply with said provisions.

FALL CREEK REGIONAL WASTE DISTRICT
Rachel E. Hu
Signature

APPLICANT
Signature

STATE OF INDIANA)
) SS:
COUNTY OF MADISON)

SUBSCRIBED and sworn to before me this ___ day of ___, 20__

My Commission Expires: Signature _____

Printed _____

Notary Public
Resident of _____ County


Inspector _____ Date Inspected _____ Approved _____ Rejected _____

Reason for Rejection _____

Date Reinspected _____ Approved _____ Rejected _____

Notes:

Size Pipe _____ Type Pipe _____
Basement Yes No
Sump Pump Yes No
Downspout to Ground Yes No
Septic Tank Pumped & Filled Yes No
Contractor _____
Special Conditions _____
Existing Home _____
New Construction _____

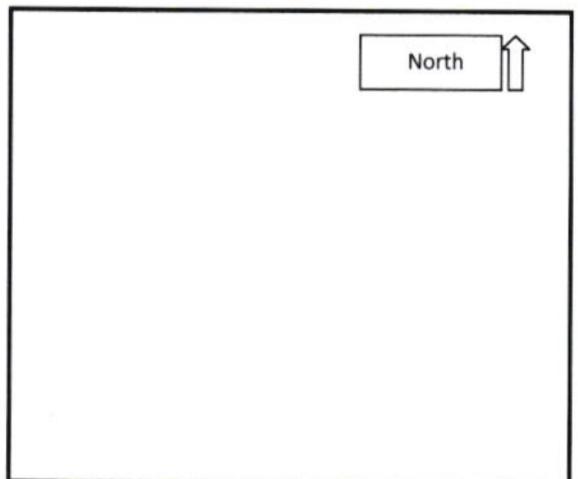




PROJECT _____ SHEET _____ OF _____

SUBJECT _____ DATE _____

JOB NO. _____

BY _____

826 S. Pendleton 11-16-2016

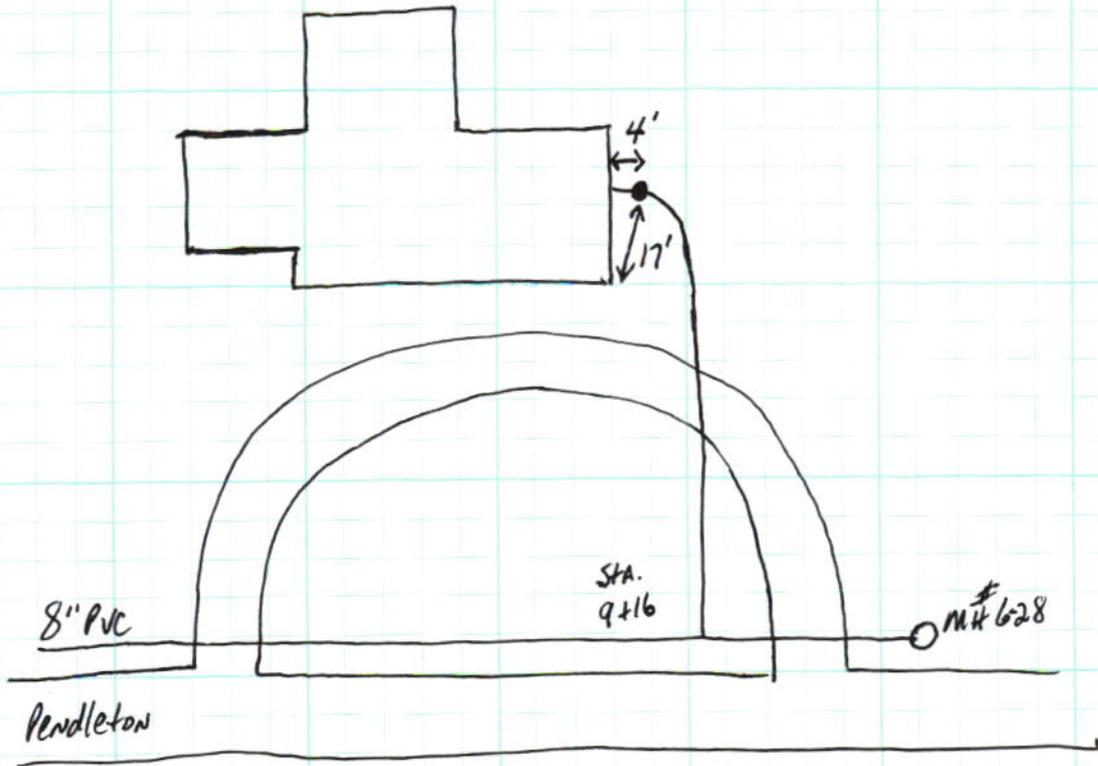

BRACKNEY SRF PHASE I