

4697


9378 S 650 WEST, P.O. BOX 59, PENDLETON, IN 46064

21-06570.00

This Agreement made and entered into this 31st day of October, 2002, between FALL CREEK REGIONAL WASTE DISTRICT ("District") and CP Morgan ("Applicant") regarding the provision of sanitary sewer service, and the assignment of capacity in, and connection to, the District's facilities for the premises located at lot #93 8375 S Shady Summerlake

1. The Applicant agrees that all workmanship and materials shall conform to all District ordinances and the District's construction standards. District will inspect and approve all work and materials before backfilling and final connection is made to the sewer mains. Any violation of this provision will cause all lines and appurtenances in violation to be removed and replaced at the Applicant's expense.

Put in
Bens
maulrof
12-02-02

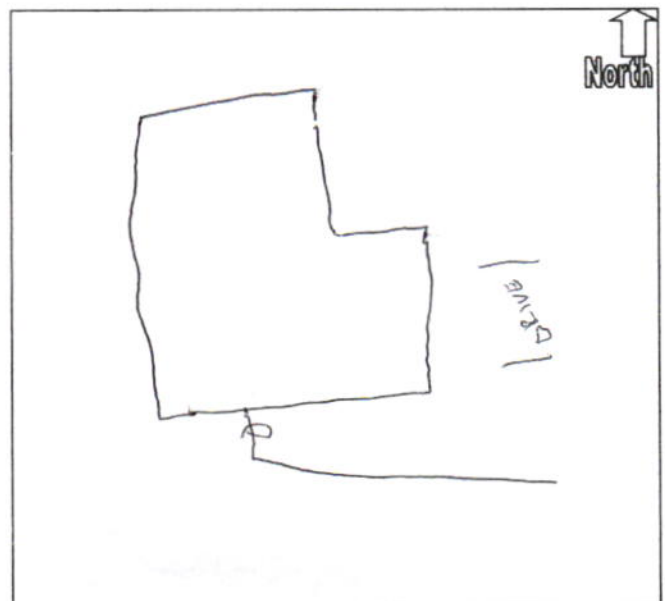NEW CONSTRUCTION 

24878

C.P. MORGAN COMMUNITIES, LP
CONSTRUCTION ACCOUNT

BANK ONE, NA
INDIANAPOLIS, INDIANA 46277
20-1-740


10/31/2002

PAY TO THE ORDER OF Fall Creek Regional Waste Dist

*****475.00

Four Hundred Seventy-Five and no/100***** DOLLARS

Fall Creek Regional Waste Dist

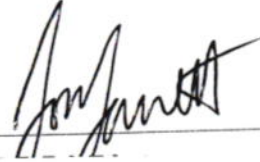

MP

MEMO 210093102 SU 93

⑈024878⑈

V V