



FALL CREEK REGIONAL WASTE DISTRICT

Box 44, Pendleton, Indiana 46064

10007
1:30

22-05000.00

20005000

Nº 000688

APPLICATION FOR SEWER PERMIT

Permit No. _____ Date 11-19-85
Permit Void 90 days from Date of Issuance
Owner Name Robert Owens
Property Address R4 Box 201 G Rose Farm
Lot # _____ P.O. Box _____
Town PEND, IN Zip Code 46064
Phone 778-4807 Water Meter _____
\$ 150.00 Tap on Fee Paid
\$ 25.00 Inspection fee paid

Application is hereby made for connection to the Fall Creek Regional Waste District Sewer System for the above listed property - Permit Type: Residential ☒, Commercial _____, Industrial _____, or Governmental/Institutional _____. User Information _____.

All workmanship and materials shall conform to the standards of the District Ordinance as described in Ordinance 84-2 and 84-3 as amended. Acceptance and approval must be made by the District inspector or his duly authorized representative before backfilling and final connection is made to the main sewer lines. Any violation of applicable regulations will cause all lines and appurtenances in violation to be removed and replaced at the owners expense.

The Fall Creek Regional Waste District is responsible for the inspection, approval of materials, and installation techniques only. All costs for materials and installation and any liabilities resulting from same is the sole responsibility of the property owner.


I have read and fully understand the above provisions and agree to comply by said provisions.

Thelma Owens
APPLICANT(S) SIGNATURE

INSPECTOR [Signature]
Date inspected 12/28/85 Approved ☒ Rejected _____
Reason for rejection _____

Date reinspected _____ Approved _____ Rejected _____

Notes:
Size Pipe 6"
Type Pipe P.V.C
Basement Yes _____ No ☒
Sump Pump Yes _____ No ☒
Downspout to Ground Yes ☒ No _____
Septic Tank Pumped & filled Yes _____ No ☒
Contractor Leroy Delo
Special Conditions Downspouts
Being into

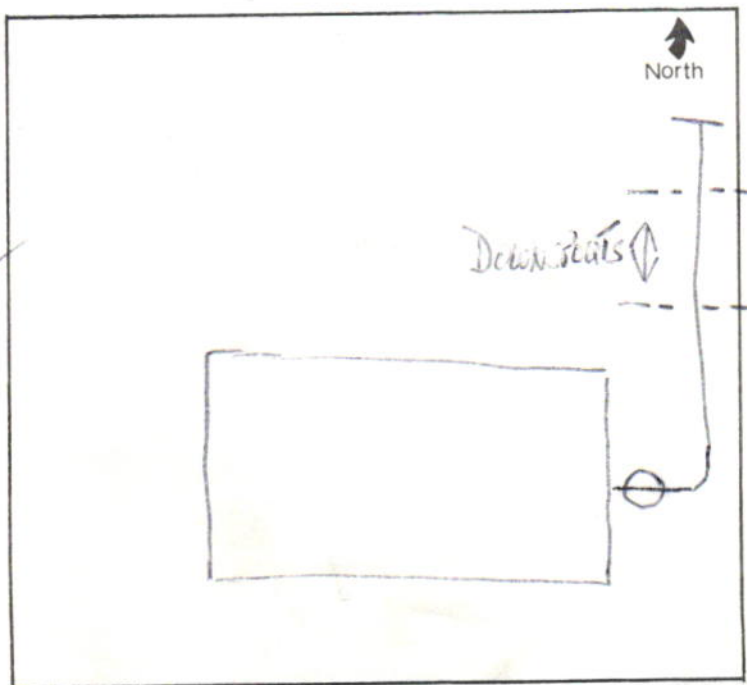

49

22-05000.



FALL CREEK REGIONAL WASTE DISTRICT

Box 44, Pendleton, Indiana 46064

PATRICIA OWENS
778-4546
TRAILER

5000.00
2-0005010.00

No 001573

APPLICATION FOR SEWER PERMIT

Permit No. _____ Date 6-26-86
Permit Void 90 days from Date of Issuance
Owner Name Robert Owens
Property Address R4 Box 201 H 827 W Seybert?
Lot # _____ P.O. Box _____
Town PENDLETON, IN Zip Code 46064
Phone _____ Water Meter _____"

\$ 500.00 Tap on Fee Paid
\$ 25.00 Inspection fee paid

Application is hereby made for connection to the Fall Creek Regional Waste District Sewer System for the above listed property - Permit Type: Residential ☒, Commercial _____, Industrial _____, or Governmental/Institutional _____. User Information _____.

All workmanship and materials shall conform to the standards of the District Ordinance as described in Ordinance 84-2 and 84-3 as amended. Acceptance and approval must be made by the District inspector or his duly authorized representative before backfilling and final connection is made to the main sewer lines. Any violation of applicable regulations will cause all lines and appurtenances in violation to be removed and replaced at the owners expense.

The Fall Creek Regional Waste District is responsible for the inspection, approval of materials, and installation techniques only. All costs for materials and installation and any liabilities resulting from same is the sole responsibility of the property owner.

I have read and fully understand the above provisions and agree to comply by said provisions.

Mr Robert Owens
APPLICANT(S) SIGNATURE

Date inspected 6-27-86 INSPECTOR [Signature]
Approved _____ Rejected _____
Reason for rejection _____

Date reinspected _____ Approved _____ Rejected _____

Notes:
Size Pipe 6"
Type Pipe PVC
Basement Yes _____ No X
Sump Pump Yes _____ No X
Downspout to Ground Yes X No _____
Septic Tank Pumped & filled Yes NA No _____
Contractor Dorp
Special Conditions TAP ON TO MAIN. LINE IS TEMP.

