



FALL CREEK REGIONAL WASTE DISTRICT

9378 S. 650 West PO Box 59
Pendleton, IN 46064-0059 778-7544

add order
on file

10-25000.00

APPLICATION FOR SEWER PERMIT

Nº 2458

Date 6/25/97

Permit Void 90 days from Date of Issuance

Owner Name Swift Eckrich Pendleton

Property Address 8282 S SR 67

Lot # _____

P.O. Box _____

Town Pendleton

IN Zip Code 46064

Phone _____

City Water ☒

Well _____

\$ 400 Tap on Fee Paid

\$ 2156 Capacity ~~Inspection~~ fee paid

Application is hereby made for connection to the Fall Creek Regional Waste District Sewer System for the above listed property - Permit Type: Residential _____, Commercial ☒, Industrial _____, or Governmental/Institutional _____. User Information _____.

All workmanship and materials shall conform to the standards of the District Ordinance as described in Ordinance 84-2 and 84-3 as amended. Acceptance and approval must be made by the District inspector or his duly authorized representative before backfilling and final connection is made to the main sewer lines. Any violation of applicable regulations will cause all lines and appurtenances in violation to be removed and replaced at the owners expense.

The Fall Creek Regional Waste District is responsible for the inspection, approval of materials, and installation techniques only. All costs for materials and installation and any liabilities resulting from same is the sole responsibility of the property owner.

I have read and fully understand the above provisions and agree to comply by said provisions.

APPLICANT(S) SIGNATURE _____

INSPECTOR [Signature]

Date inspected 9-19-97 Approved _____

Rejected _____

Reason for rejection _____

Date reinspected _____

Approved _____

Rejected _____

Notes:

Size Pipe 6 "

Type Pipe PVC

Basement Yes _____ No ☒

Sump Pump Yes _____ No ☒

Downspout to Ground Yes ☒ No _____


Septic Tank Pumped & filled Yes _____ No ☒

Contractor Construction

Special Conditions (MIM EXC. TEMP SENSE)

Existing Home _____

New Construction ☒

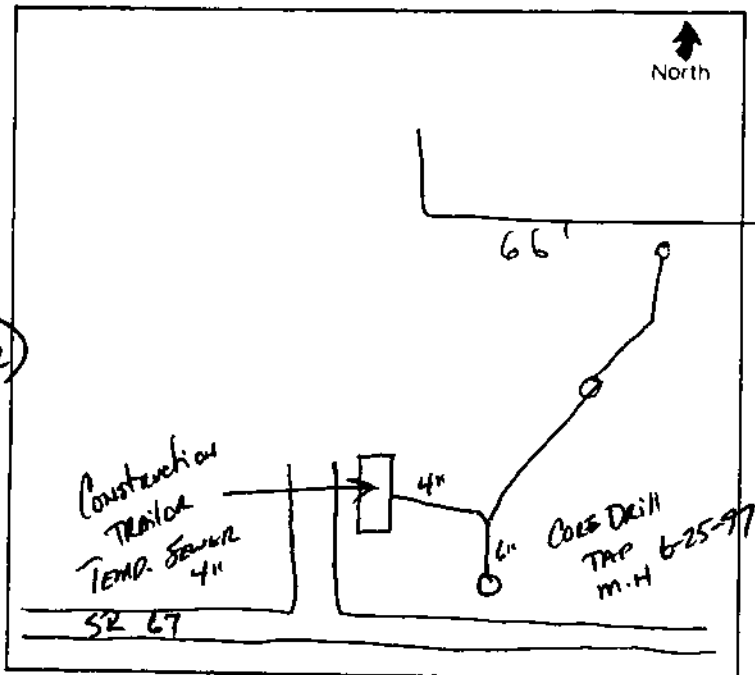

SWIFT ECKRICH PENDLETON

P O BOX 61
ZIONSVILLE, IN 46077

1007

71-859/749

June 24

1987

PAY
TO THE
ORDER OF FCRWD

\$ 2,556.00

Two Thousand Five Hundred Fifty-Six and No/100***

DOLLARS

Security features
included
Circle on back



Fifth Third Bank
OF CENTRAL INDIANA
NORTH MERIDIAN STREET BANKING CENTER
9425 NORTH MERIDIAN STREET
INDIANAPOLIS, IN 46260

FOR Sewer Tap Fee (Swift Pendleton)

⑈001007⑈ ⑆074908594⑆