

FALL CREEK REGIONAL WASTE DISTRICT

9378 S 650 WEST, P.O. BOX 59, PENDLETON, IN 46064

765-778-7544

AGREEMENT FOR SANITARY SEWER SERVICE

This Agreement made and entered into this 23rd day of April, 2003, between FALL CREEK REGIONAL WASTE DISTRICT ("District") and CP Morgan ("Applicant") regarding the provision of sanitary sewer service, and the assignment of capacity in, and connection to, the District's facilities for the premises located at N. Quarter Moon Dr Lot 87 8284 S Quarter Moon

NOW THEREFORE, the parties, in consideration of the mutual promises set out in this Agreement, the receipt and sufficiency of which is hereby acknowledged, agree as follows:

1. The Applicant agrees that all workmanship and materials shall conform to all District ordinances and the District's construction standards. District must accept and approve all work and materials before backfilling and final connection is made to the sewer mains. Any violation of this provision will cause all lines and appurtenances in violation to be removed and replaced at the Applicant's expense.

2. The District shall have access to the Applicant's premises at all reasonable times to inspect, repair, or replace any equipment or facilities in the District's service or which has an impact on said service.

3. The Applicant shall be responsible for the payment of rates, capacity charges, and tap fees. The failure to pay any rate charge or property, the cost of which will be borne by the Applicant, or the termination of service to the property, limited to, all attorney's fees and collection costs.

4. The District shall not be liable for any damages as a result of any failure to supply service unless said damages are due to default, neglect or culpability on the part of the District.

5. If there is an available sanitary sewer within three hundred (300) feet of the property line, the property owner shall be required to connect to the District's sanitary sewer system.

6. The Applicant and District agree that the provision of sanitary sewer service touches and concerns the property and the terms of this Agreement bind the District and Applicant and their heirs, executors, administrators, personal representatives, successors, agents, attorneys, assigns, designees, and transferees.

The parties hereto have read and fully understand the above provisions and agree to comply with said provisions.

FALL CREEK REGIONAL WASTE DISTRICT
Teresa Hutton
Signature

APPLICANT
Deborah Green
Signature

STATE OF INDIANA)
) SS:
COUNTY OF MADISON)

SUBSCRIBED and sworn to before me this 23rd day of April, 2003.

My Commission Expires:
4-19-2008

Signature Teresa K. Hutton

Printed Teresa K. Hutton

Notary Public
Resident of Madison County

INSPECTOR Don DATE INSPECTED 5/14/03 APPROVED ✓ REJECTED _____

REASON FOR REJECTION _____

DATE REINSPECTED _____ APPROVED _____ REJECTED _____

NOTES: SIZE PIPE 6 TYPE PIPE 35

BASEMENT YES NO ✓

SUMP PUMP YES NO ✓

DOWNSPOUT TO GROUND YES NO ✓


SEPTIC TANK PUMPED & FILLED YES NO ✓

CONTRACTOR _____

SPECIAL CONDITIONS _____

EXISTING HOME _____

NEW CONSTRUCTION ✓

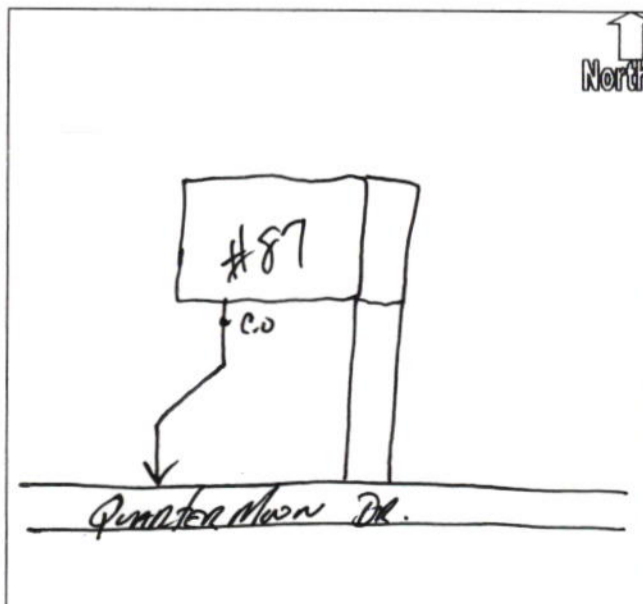

27120

C.P. MORGAN COMMUNITIES, LP
CONSTRUCTION ACCOUNT

BANK ONE, NA
INDIANAPOLIS, INDIANA 46277
20-1-740

4/22/2003

PAY TO THE ORDER OF Fall Creek Regional Waste Dist

\$ ***2,635.00

Two Thousand Six Hundred Thirty-Five and no/100***** DOLLARS

MEMO 210087102 SU 87

James L. Davis

MP

⑈027120⑈ ⑈074000010⑈