

add order
on file



FALL CREEK REGIONAL WASTE DISTRICT

9378 S. 650 West PO Box 59
Pendleton, IN 46064-0059 778-7544

26-05790.00

APPLICATION FOR SEWER PERMIT

Nº 2916

Date 11/3/00

Permit Void 90 days from Date of Issuance

Owner Name Reginald Holt

Property Address 8293 W 1000 S

Lot # _____ P.O. Box _____

Town Fortville, IN Zip Code 46040

Phone _____ City Water _____ Well ☒

\$ N/A Tap on Fee Paid

\$ N/A Inspection fee paid

Application is hereby made for connection to the Fall Creek Regional Waste District Sewer System for the above listed property - Permit Type: Residential ☒, Commercial _____, Industrial _____, or Governmental/Institutional _____. User Information _____.

All workmanship and materials shall conform to the standards of the District Ordinance as described in Ordinance 84-2 and 84-3 as amended. Acceptance and approval must be made by the District inspector or his duly authorized representative before backfilling and final connection is made to the main sewer lines. Any violation of applicable regulations will cause all lines and appurtenances in violation to be removed and replaced at the owners expense.

The Fall Creek Regional Waste District is responsible for the inspection, approval of materials, and installation techniques only. All costs for materials and installation and any liabilities resulting from same is the sole responsibility of the property owner.

I have read and fully understand the above provisions and agree to comply by said provisions.

APPLICANT(S) SIGNATURE _____

INSPECTOR B

Date inspected 5-29-01 Approved ☒ Rejected _____

Reason for rejection _____

Date reinspected _____ Approved _____ Rejected _____

Notes:

Size Pipe 4 "

Type Pipe PVC

Basement Yes ☒ No _____

Sump Pump Yes _____ No ☒

Downspout to Ground Yes ☒ No _____


Septic Tank Pumped & filled Yes ☒ No _____

Contractor Self

Special Conditions _____

Existing Home ☒

New Construction _____

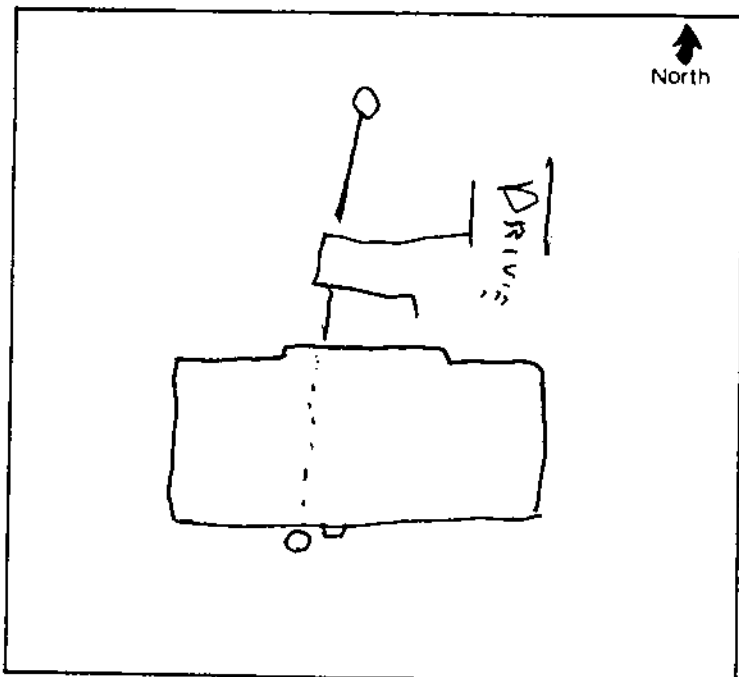




INDIANA-MICHIGAN VALVES INDIANAPOLIS

5603 West Raymond ■ Suite J
Indianapolis, Indiana 46241

317/240-2878 ■ 800/222-5816 ■ Fax: 317/241-4816

After-Hours Emergency Service:
888/392-2215

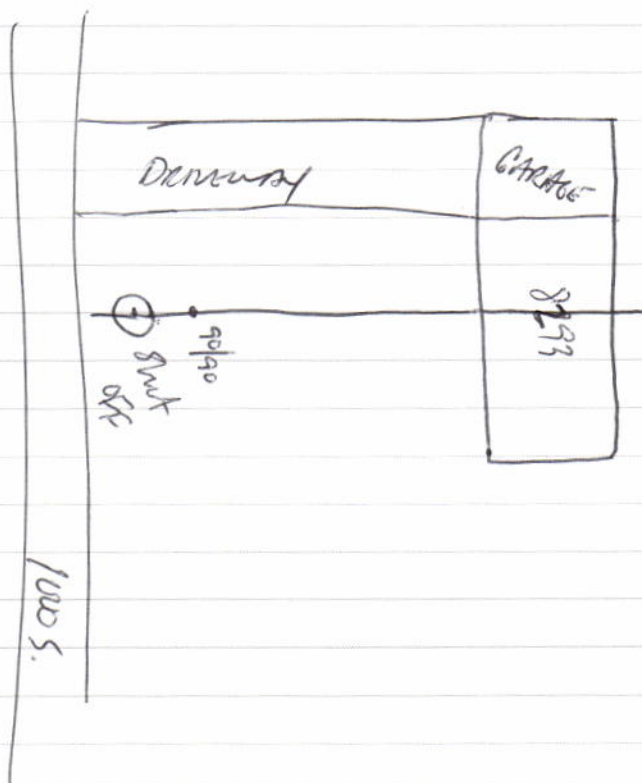

11-3-00
HWT
8293

THE JOLIET VALVE COMPANIES

The Leading Midwestern PVF Distributors

Minooka, IL ■ Decatur, IL ■ Kankakee, IL ■ Rockford, IL ■ Stickney, IL
Zion, IL ■ East Chicago, IN ■ Indianapolis, IN ■ Fort Wayne, IN
South Bend, IN ■ Terre Haute, IN ■ Beulah, ND ■ Mandan, ND



Printed on recycled paper.