


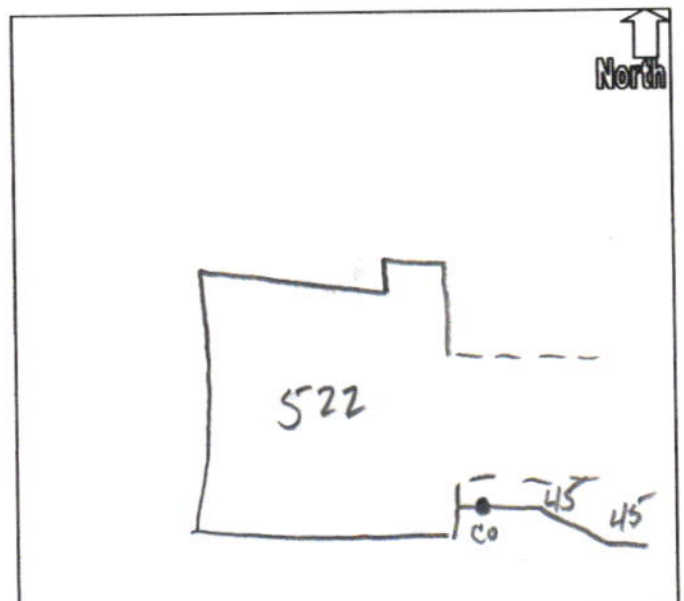

37858

C.P. MORGAN COMMUNITIES, LP
CONSTRUCTION ACCOUNT

BANK ONE, NA
INDIANAPOLIS, INDIANA 46277
20-1-740

6/29/2005

PAY TO THE ORDER OF Fall Creek Regional Waste Dist

***2,635.00


Two Thousand Six Hundred Thirty-Five and no/100*****\$*****

DOLLARS

Fall Creek Regional Waste Dist

210522

MEMO

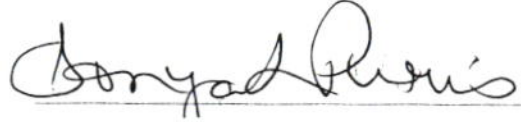

⑈037858⑈ ⑆074000010⑆