


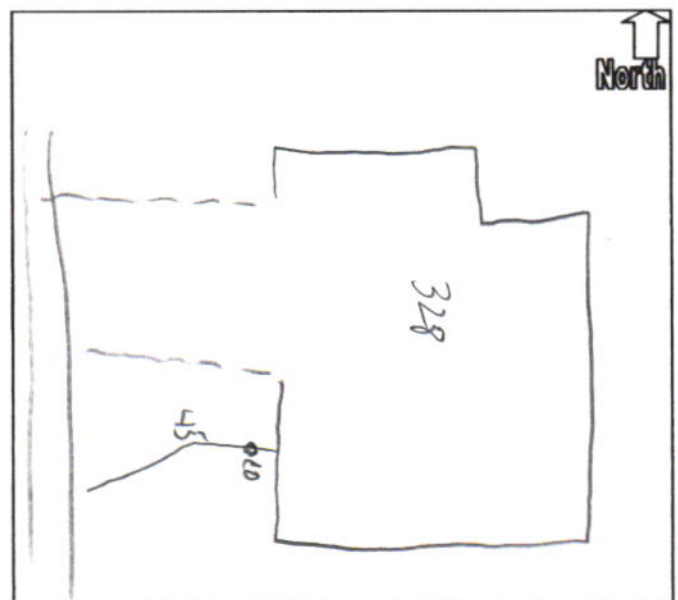

31619

C.P. MORGAN COMMUNITIES, LP
CONSTRUCTION ACCOUNT

BANK ONE, NA
INDIANAPOLIS, INDIANA 46277
20-1-740


3/31/2004

PAY TO THE ORDER OF Fall Creek Regional Waste Dist

*****475.00

Four Hundred Seventy-Five and no/100*****
DOLLARS

MEMO 210328102 SU 328 James Wallace

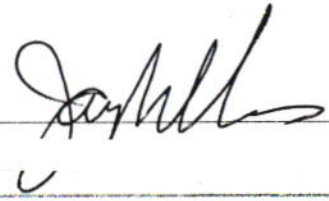

⑈031619⑈ ⑈074000010⑈

Details on back.
Security Features Included.