

Cynthia Hill

FALL CREEK REGIONAL WASTE DISTRICT

4733

9378 S 650 WEST, P.O. BOX 59, PENDLETON, IN 46064

765-778-7544

21-06615-00

AGREEMENT FOR SANITARY SEWER SERVICE

This Agreement made and entered into this 6th day of January, 2003, between FALL CREEK REGIONAL WASTE DISTRICT ("District") and CP Morgan ("Applicant") regarding the provision of sanitary sewer service, and the assignment of capacity in, and connection to, the District's facilities for the premises located at Lot #102 Shady Trail Summerlake
8335.8

NOW THEREFORE, the parties, in consideration of the mutual promises set out in this Agreement, the receipt and sufficiency of which is hereby acknowledged, agree as follows:

1. The Applicant agrees that all workmanship and materials shall conform to all District ordinances and the District's construction standards. District must accept and approve all work and materials before backfilling and final connection is made to the sewer mains. Any violation of this provision will cause all lines in violation to be removed and replaced at the Applicant's expense.

2. The District shall have the right to enter upon the Applicant's property to inspect, repair, or replace any equipment used in connection with the District's service on said service.

3. The Applicant shall be responsible for all monthly user rates, The failure to pay any rate charge or fee may result in a lien against the property, the cost of which will be borne by Applicant, including, but not limited to, connection costs.

4. The District shall not be responsible for any damages as a result of any failure to supply service unless said damages are due to default, neglect or culpability on the part of the District.

5. If there is an available sanitary sewer within three hundred (300) feet of the property line, the property owner shall be required to connect to the District's sanitary sewer system.

6. The Applicant and District agree that the provision of sanitary sewer service touches and concerns the property and the terms of this Agreement bind the District and Applicant and their heirs, executors, administrators, personal representatives, successors, agents, attorneys, assigns, designees, and transferees.

The parties hereto have read and fully understand the above provisions and agree to comply with said provisions.

FALL CREEK REGIONAL WASTE DISTRICT

Signature

APPLICANT

Signature

STATE OF INDIANA)

) SS:

COUNTY OF MADISON)

SUBSCRIBED and sworn to before me this 6th day of January, 2003.

My Commission Expires:

4-29-09

Signature

Printed

Jan E Carey
Notary Public
Resident of Madison County

INSPECTOR Ben DATE INSPECTED 2-3-3 APPROVED ✓ REJECTED _____

REASON FOR REJECTION _____

DATE REINSPECTED _____ APPROVED _____ REJECTED _____

NOTES:

SIZE PIPE 6 TYPE PIPE PVC

BASEMENT YES _____ NO ✓

SUMP PUMP YES _____ NO ✓

DOWNSPOUT TO GROUND YES ✓ NO _____


SEPTIC TANK PUMPED & FILLED YES _____ NO ✓

CONTRACTOR Buttz

SPECIAL CONDITIONS _____

EXISTING HOME _____

NEW CONSTRUCTION ✓

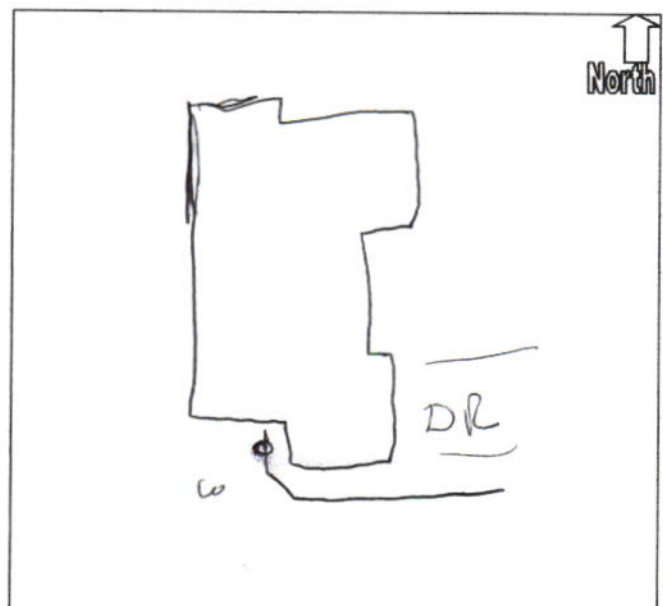

25644

C.F. MORGAN COMMUNITIES, LP
CONSTRUCTION ACCOUNT

BANK ONE, NA
INDIANAPOLIS, INDIANA 46277
20-1-740

12/27/2002

PAY TO THE ORDER OF Fall Creek Regional Waste Dist

\$ *****475.00


Four Hundred Seventy-Five and no/100*****

DOLLARS

Fall Creek Regional Waste Dist

MEMO 210174102 SU 174

⑈025644⑈

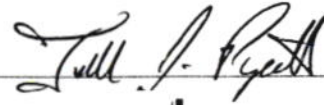

MP

RECEIPT

FALL CREEK REGIONAL WASTE DISTRICT
P.O. BOX 59, CO. RD. 650 WEST

No 7695

gen FUND

PENDLETON IN. 46064, 12 27 02
MONTH DAY YEAR

369100

RECEIVED FROM C P Morgan \$ 1425.00

THE SUM OF Fourteen hundred twenty five and 100/100 DOLLARS

ON ACCOUNT OF tap fees for Lots #173,
102 + 38 Summerlake

PAYMENT TYPE & AMOUNT:

CASH 25643 CHECK 25624 M.O. 25644

E.F.T. C.C./B.C. OTHER

Jan E Carey

AUTHORIZED SIGNATURE