

4990

9378 S 650 WEST, P.O. BOX 59, PENDLETON, IN 46064

765-778-7544

21-07525.00

This Agreement made and entered into this 3rd day of October, 2003, between FALL CREEK REGIONAL WASTE DISTRICT ("District") and CP Morgan ("Applicant") regarding the provision of sanitary sewer service, and the assignment of capacity in, and connection to, the District's facilities for the premises located at Lot # 284 Summerlake

8340 S. Rising Sun Dr.

- The parties hereto have read and fully understand the above provisions and agree to comply with said provisions.

FALL CREEK REGIONAL W
Jan E. Carey
 Signature

APPLICANT Deborah Green
Signature

[illegible]

SUBSCRIBED and sworn to before me this 3rd day of October, 2003.

My Commission Expires: 4-29-09

Signature Jan E. Carey
Printed Jan E. Carey
Notary Public
Resident of Madison County

INSPECTOR B DATE INSPECTED 10-9-03 APPROVED ✓ REJECTED _____

REASON FOR REJECTION _____

DATE REINSPECTED _____ APPROVED _____ REJECTED _____

NOTES: SIZE PIPE 6 TYPE PIPE PVC

BASEMENT YES NO ^y

SUMP PUMP YES NO *Y*

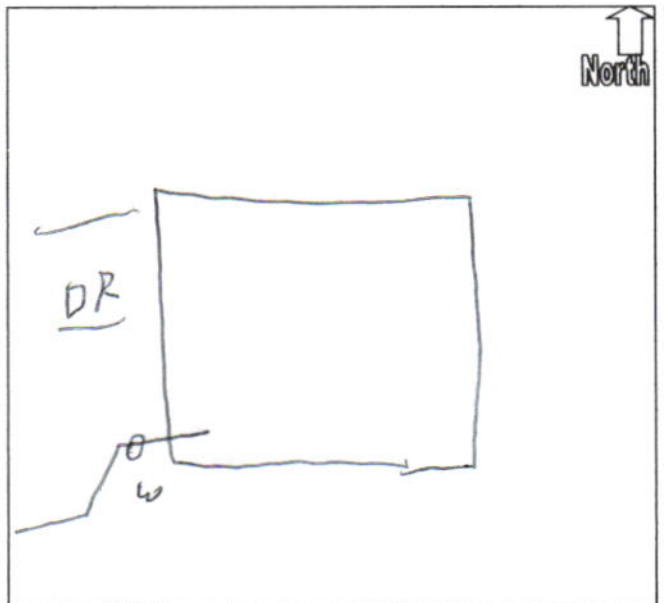
DOWNSPOUT TO GROUND YES ✓ NO

SEPTIC TANK PUMPED & FILLED YES NO ☒

CONTRACTOR Butz

SPECIAL CONDITIONS

EXISTING HOME _____

NEW CONSTRUCTION X

29784

C.P. MORGAN COMMUNITIES, LP
CONSTRUCTION ACCOUNT

BANK ONE, NA
INDIANAPOLIS, INDIANA 46277
20-1-740

10-3-03

PAY TO THE
ORDER OF

Fall Creek Regional Wastewater \$ 475.00
Four Hundred Seventy Five and 00/100 DOLLARS

MEMO

SU 284

Deloris Gosley

George J. Lewis

MP

⑈029784⑈