


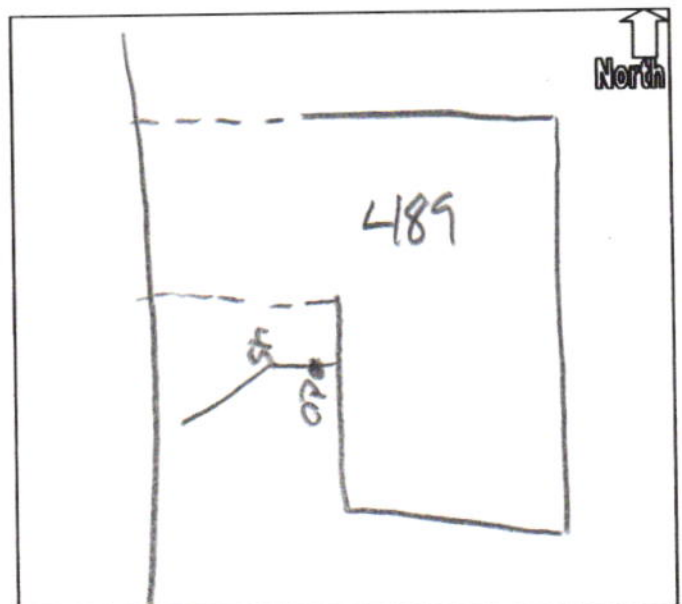

34600

C.P. MORGAN COMMUNITIES, LP
CONSTRUCTION ACCOUNT

BANK ONE, NA
INDIANAPOLIS, INDIANA 46277
20-1-740

10/4/2004

PAY TO THE ORDER OF Fall Creek Regional Waste Dist

\$*****475.00

Four Hundred Seventy-Five and no/100***** DOLLARS

Fall Creek Regional Waste Dist

MEMO 210489

Jonny Hines

⑈034600⑈ ⑆074000010⑆