


21-06740.00

AGREEMENT FOR SANITARY SEWER SERVICE

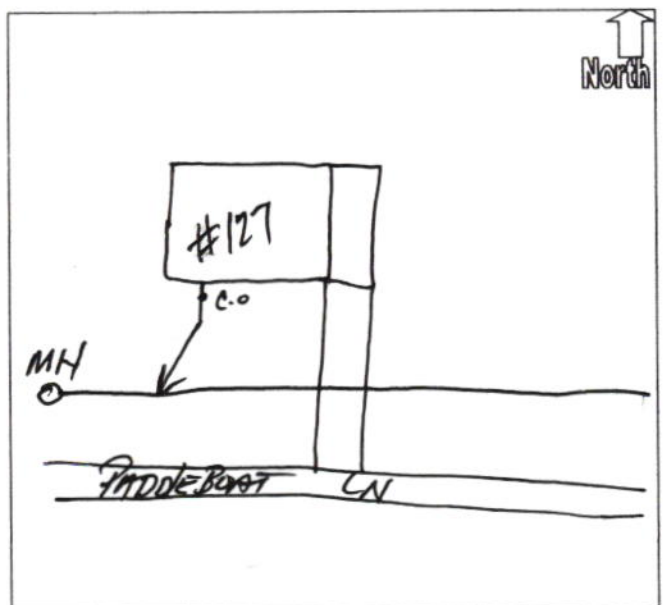

26351

C.P. MORGAN COMMUNITIES, LP
CONSTRUCTION ACCOUNT

BANK ONE, NA
INDIANAPOLIS, INDIANA 46277
20-1-740

2/28/2003

PAY TO THE ORDER OF Fall Creek Regional Waste Dist

\$ *****475.00

Four Hundred Seventy-Five and no/100***** DOLLARS

MEMO 210127102 SU 127

Jonas P. [Signature]

MP

⑈026351⑈ ⑈074000010⑈