


LOCATES

Maple Trails

Lot 93 8362 Juniper Ln  
4/16/24 Mr. Watson

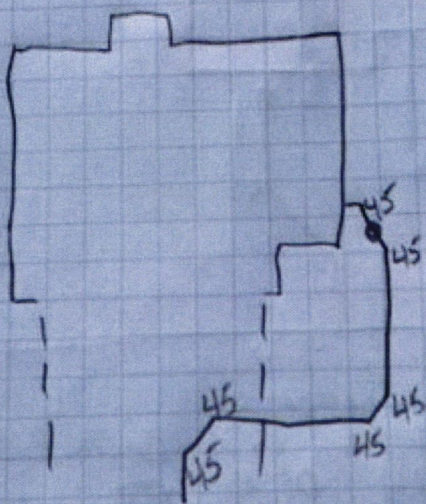

↑ N





