

№ 5272

765-778-7544

21-08545.00

8368 S. Midnight Dr

Hand-drawn sketch map of a street intersection. The map shows "MIDNIGHT DRIVE" on the left, "MAIN" at the bottom, and "QUARTER MOON" at the bottom. A large rectangle represents a building. A dashed line indicates a path or boundary. A circle with a dot is labeled "CO" and "45". A north arrow is in the top right corner.

33156

C.P. MORGAN COMMUNITIES, LP
CONSTRUCTION ACCOUNT

BANK ONE, NA
INDIANAPOLIS, INDIANA 46277
20-1-740

6/30/2004

PAY TO THE Fall Creek Regional Waste Dist
ORDER OF

*****475.00

Four Hundred Seventy-Five and no/100*****


DOLLARS

Fall Creek Regional Waste Dist

210488102 SU 488

MEMO

Jeremy Morris

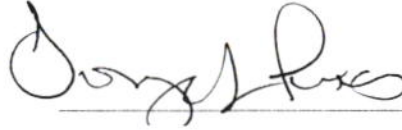

⑈033156⑈ ⑆074000010⑆

Details on back
Security Features Included