



№ 5052

21-07720.00

AGREEMENT FOR SANITARY SEWER SERVICE

8378 S. Swimming Hole Lane
NOW THEREFORE, the parties, in consideration of the mutual promises set out in this Agreement, the receipt and sufficiency of which is hereby acknowledged, agree as follows:

The parties hereto have read and fully understand the above provisions and agree to comply with said provisions.

FALL CREEK REGIONAL WASTE DISTRICT
Jan E. Carey
 Signature

APPLICANT Deborah Greer
Signature

STATE OF INDIANA)
) SS:
COUNTY OF MADISON)

SUBSCRIBED and sworn to before me this 19th day of November, 2003.

My Commission Expires:
4-29-09

Signature Jan E. Carey
Printed Jan E. Carey
Notary Public
Resident of Madison County

INSPECTOR 1360 DATE INSPECTED 12-1-03 APPROVED ☒ REJECTED ☐

REASON FOR REJECTION

DATE REINSPECTED	APPROVED	REJECTED
------------------	----------	----------

NOTES: 6 TYPE PIPE PUC

BASEMENT YES NO X

SUMP PUMP YES NO χ

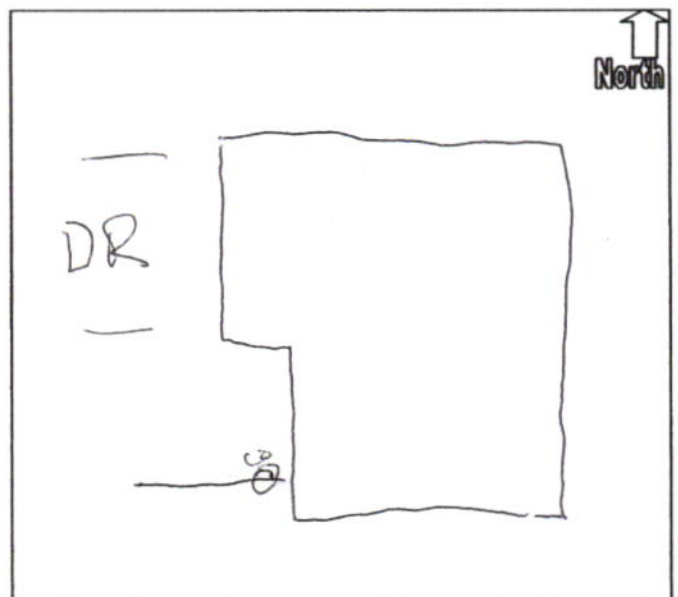
DOWNSPOUT TO GROUND YES ☒ NO

SEPTIC TANK PUMPED & FILLED YES NO ☒

CONTRACTOR Buttz

SPECIAL CONDITIONS

EXISTING HOME

NEW CONSTRUCTION ☒

30350

C.P. MORGAN COMMUNITIES, LP
CONSTRUCTION ACCOUNT

BANK ONE, NA
INDIANAPOLIS, INDIANA 46277
20-1-740

11/19/2003

PAY TO THE ORDER OF Fall Creek Regional Waste Dist

*****475.00

Four Hundred Seventy-Five and no/100*****
DOLLARS

MEMO 210323102 SU 323 Craig VanBrunt

[Signature]

⑈030350⑈ ⑆074000010⑆