
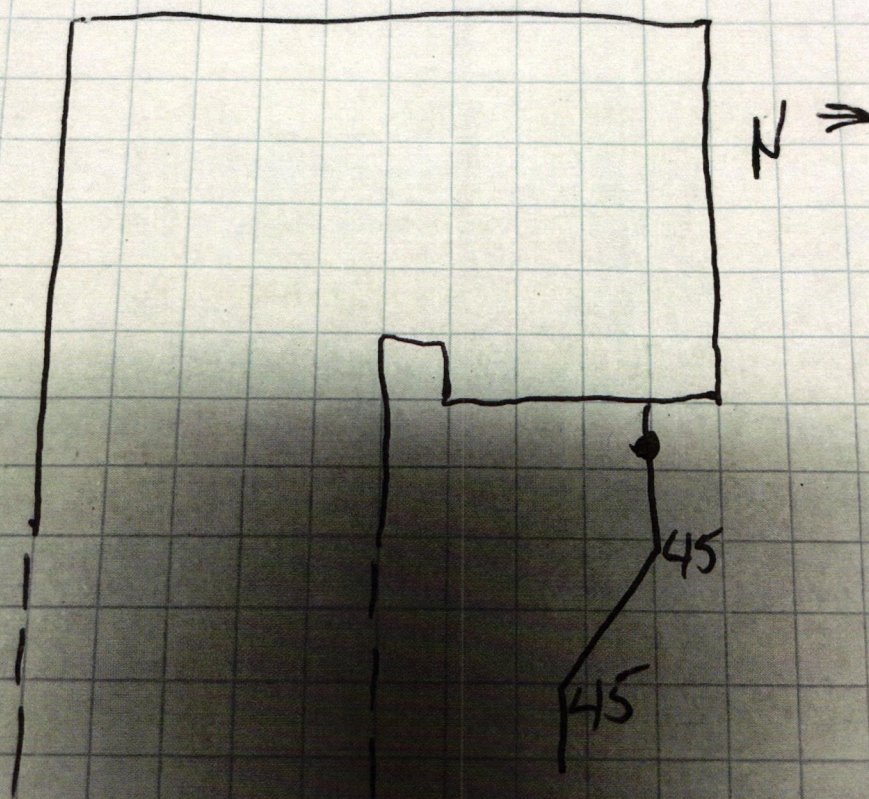


North 

Drawing  
+  
4 picture  
attached



Estes Park  
Lot 71 8379 Canyon  
5/10/23 pr water



MT



