

Jessica Higgason

FALL CREEK REGIONAL WASTE DISTRICT

9378 S 650 WEST, P.O. BOX 59, PENDLETON, IN 46064

765-778-7544

AGREEMENT FOR SANITARY SEWER SERVICE

4812

21-06640.00

This Agreement made and entered into this 10th day of April, 2003, between FALL CREEK REGIONAL WASTE DISTRICT ("District") and C.P. Morgan ("Applicant") regarding the provision of sanitary sewer service, and the assignment of capacity to, and connection to, the District's facilities for the premises located at Lot #107 Shady Trail Drive Summerlake
8381 S. Shady Trail

NOW THEREFORE, the parties, in consideration of the mutual promises set out in this Agreement, the receipt and sufficiency of which is hereby acknowledged, agree as follows:

1. The Applicant's workmanship and materials shall conform to all District ordinances and the District's code. The Applicant shall accept and approve all work and materials before backfilling and final connection is made. Violation of this provision will cause all lines and appurtenances in violation to be removed at the Applicant's expense.

2. The District reserves the right to inspect upon the Applicant's premises at all reasonable times to inspect, repair, or replace any connection with the District's service or which has an impact on said service.

3. The Applicant shall be responsible for all monthly user rates, capacity charges, and tap fees. The failure to pay any rate charge or fee may result in a lien against the property and/or the termination of service to the property, the cost of which will be borne by Applicant, including, but not limited to, all attorney's fees and collection costs.

4. The District shall not be responsible for any damages as a result of any failure to supply service unless said damages are due to default, neglect or culpability on the part of the District.

5. If there is an available sanitary sewer within three hundred (300) feet of the property line, the property owner shall be required to connect to the District's sanitary sewer system.

6. The Applicant and District agree that the provision of sanitary sewer service touches and concerns the property and the terms of this Agreement bind the District and Applicant and their heirs, executors, administrators, personal representatives, successors, agents, attorneys, assigns, designees, and transferees.

The parties hereto have read and fully understand the above provisions and agree to comply with said provisions.

FALL CREEK REGIONAL WASTE DISTRICT
Jan E. Carey
Signature

APPLICANT
Deborah Green
Signature

STATE OF INDIANA)
) SS:
COUNTY OF MADISON)

SUBSCRIBED and sworn to before me this 10th day of April, 2003.

My Commission Expires:
4-29-09

Signature Jan E. Carey
Printed Jan E. Carey
Notary Public
Resident of Madison County

INSPECTOR B DATE INSPECTED 6-5-03 APPROVED ✓ REJECTED _____

REASON FOR REJECTION _____

DATE REINSPECTED _____ APPROVED _____ REJECTED _____

NOTES:
SIZE PIPE 6 TYPE PIPE PVC

BASEMENT YES _____ NO X

SUMP PUMP YES _____ NO X

DOWNSPOUT TO GROUND YES X NO _____


SEPTIC TANK PUMPED & FILLED YES _____ NO X

CONTRACTOR Butt

SPECIAL CONDITIONS _____

EXISTING HOME _____

NEW CONSTRUCTION X

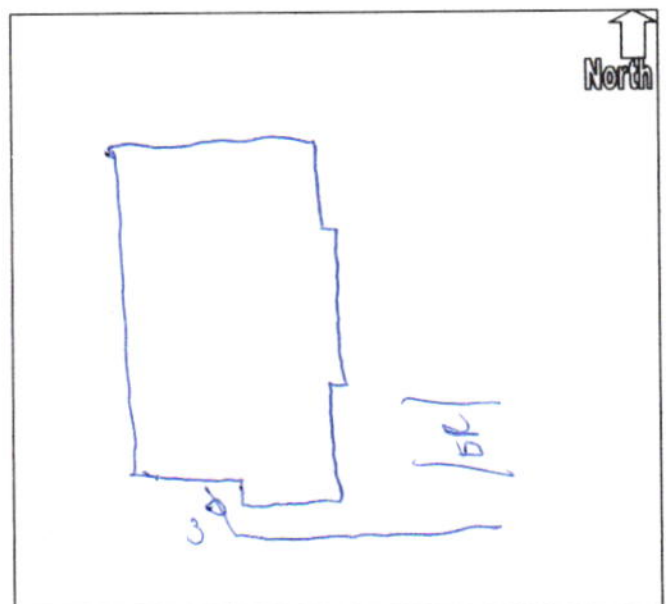

C.P. MORGAN COMMUNITIES, LP
CONSTRUCTION ACCOUNT

BANK ONE, NA
INDIANAPOLIS, INDIANA 46277
20-1-740

26867

4/8/2003

PAY TO THE ORDER OF Fall Creek Regional Waste Dist

\$ ***2,160.00


Two Thousand One Hundred Sixty and no/100*****

DOLLARS

MEMO

210107102 SU 107

Jessica Higson

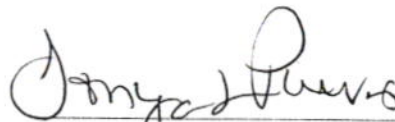

MP

⑈026867⑈

C.P. MORGAN COMMUNITIES, LP
CONSTRUCTION ACCOUNT

4/11/2003

*****475.00

Four Hundred Seventy-Five and no/100*****
DOLLARS

George H. H. H.

026964