


21-10005.00

## AGREEMENT FOR SANITARY SEWER SERVICE

**NOW THEREFORE**, the parties, in consideration of the mutual promises set out in this Agreement, the receipt and sufficiency of which is hereby acknowledged, agree as follows:

- The parties hereto have read and fully understand the above provisions and agree to comply with said provisions.

NEW CONSTRUCTION ✓

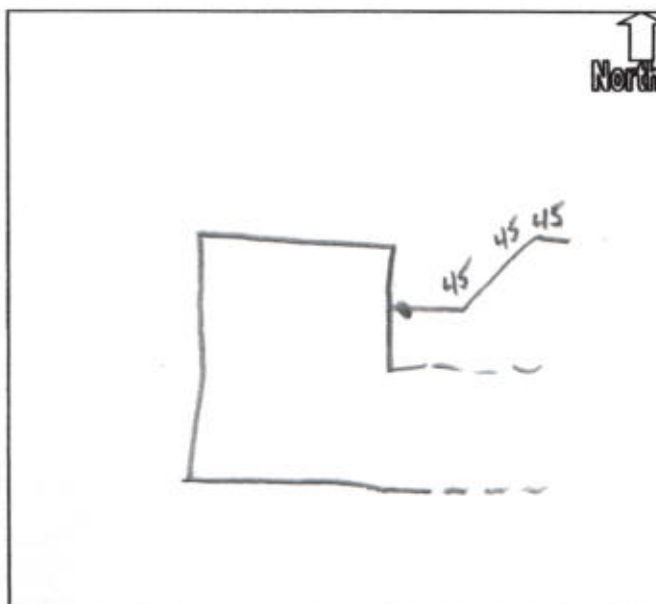

40857

C.P. MORGAN COMMUNITIES, LP  
CONSTRUCTION ACCOUNT

JPMORGAN CHASE BANK, N.A.  
INDIANAPOLIS, INDIANA 46277  
20-1-740

5/9/2006

PAY TO THE ORDER OF Fall Creek Regional Waste Dist

\*\*\*1,900.00

One Thousand Nine Hundred and no/100\*\*\*\*\*\$\*\*\*\*\*

DOLLARS

Fall Creek Regional Waste Dist

MEMO SU 762, 783, 814, 833



⑈040857⑈ ⑆074000010⑆ 70500138719⑈