

Fall Creek Regional Waste District
9378 S 650 W, P.O. Box 59, Pendleton, IN 46064
765-778-7544

#6727

Agreement for Sanitary Sewer Service

This Agreement made and entered into this 31 day of August, 2017, between Fall Creek Regional Waste District ("District") and Jason Williamson ("Applicant") regarding the provision of sanitary sewer service, and the assignment of capacity in and connection to, the District's facilities for the premises located at 8424 W 875 S.

Street Address: _____

Now therefore, the parties, in consideration of the mutual promises set out in this Agreement, the receipt and sufficiency of which is hereby acknowledged, agree as follows:

1. The Applicant agrees that all workmanship and materials shall conform to all District ordinances and the District's construction standards. District must accept and approve all work and materials before backfilling and final connection is made to the sewer mains. Any violation of this provision will cause all lines and appurtenances in violation to be removed and replaced at the Applicant's expense.
2. The District shall have the right to enter upon the Applicant's premises at all reasonable times to inspect, repair, or replace any equipment used in connection with the District's service or which has an impact on said service.
3. The Applicant shall be responsible for all monthly user rates, capacity charges, and tap fees. The failure to pay any rate charge or fee may result in a lien against the property and/or the termination of service to the property, the cost of which will be borne by Applicant, including, but not limited to, all attorney's fees and collection costs.
4. The District shall not be responsible for any damages as a result of any failure to supply service unless said damages are due to default, neglect or culpability on the part of the District.
5. If there is an available sanitary sewer within three hundred (300) feet of the property line, the property owner shall be required to connect to the District's sanitary sewer system.
6. The Applicant and District agree that the provision of sanitary sewer service touches and concerns the property and the terms of this Agreement bind the District and Applicant and their heirs, executors, administrators, personal representatives, successors, agents, attorneys, assigns, designees, and transferees.


The parties hereto have read and fully understand the above provisions and agree to comply with said provisions.

FALL CREEK REGIONAL WASTE DISTRICT
Rachel E. Anderson
Signature

APPLICANT
Jason Williamson
Signature

STATE OF INDIANA)
) SS:
COUNTY OF MADISON)

SUBSCRIBED and sworn to before me this 31 day of August, 2017

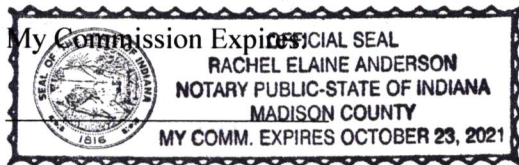


Signature Rachel E. Anderson
Printed Rachel E. Anderson
Notary Public
Resident of Madison County

Inspector SN Date Inspected 8/6/18 Approved ✓ Rejected _____
Reason for Rejection _____

Date Reinspected _____ Approved _____ Rejected _____

Notes:

Size Pipe 4" 1 1/2 Type Pipe 35 160 PSI
Basement Yes _____ No _____
Sump Pump Yes _____ No _____
Downspout to Ground Yes _____ No _____
Septic Tank Pumped & Filled Yes _____ No _____
Contractor Kaffer
Special Conditions _____
Existing Home _____
New Construction ✓

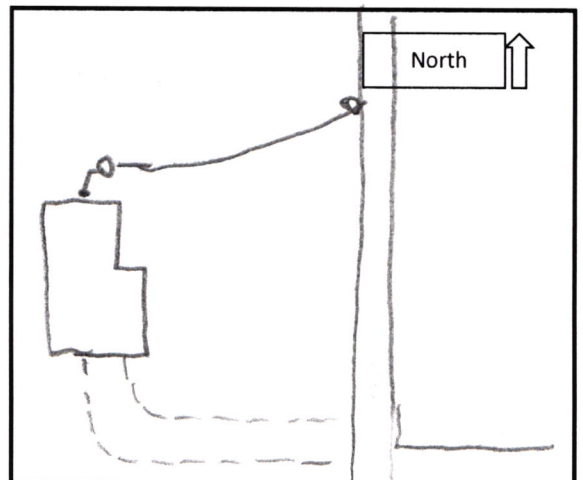

2 Pictures attached

8424 W 8755

Steve Meholson

8.6.18



8424 W 875 S

Steve Meholsen

8-6-18



Prescribed by State Board of Accounts
Y2051

RECEIPT

Boyce Forms Systems, Daleville, IN General Form No. 352 (REV. 1997)

FALL CREEK REGIONAL WASTE DISTRICT

P.O. BOX 59 CO. RD. 650 WEST

NO. 010666

General FUND

PENDLETON, IN 46064

DATE Aug. 31, 2017

RECEIVED FROM Jason Williamson

THE SUM OF five thousand eight hundred forty-one 70 DOLLARS

ON ACCOUNT OF 875 S.

100

PAYMENT TYPE
AND AMOUNT:

CASH ☒ CHECK ☐ M.O. ☐
E.F.T. ☐ C.C./B.C. ☐ OTHER ☐

Cap fee (2800) Tap fee (570) Grinder (2471.70)

Richard G. Williams

AUTHORIZED SIGNATURE

Prescribed by State Board of Accounts
Y2051

RECEIPT

Boyce Forms Systems, Daleville, IN General Form No. 352 (REV. 1997)

FALL CREEK REGIONAL WASTE DISTRICT

P.O. BOX 59 CO. RD. 650 WEST

NO. 010667

 FUND

PENDLETON, IN 46064

DATE , 20

RECEIVED FROM

THE SUM OF