

FALL CREEK REGIONAL WASTE DISTRICT

No 5608

9378 S 650 WEST, P.O. BOX 59, PENDLETON, IN 46064

765-778-7544

AGREEMENT FOR SANITARY SEWER SERVICE

owner: Willhoite
 This Agreement made and entered into this 24th day of June, 2005, between FALL CREEK REGIONAL WASTE DISTRICT ("District") and Redbud Estates ("Applicant") regarding the provision of sanitary sewer service, and the assignment of capacity in, and connection to, the District's facilities for the premises located at Esche 107 4 84 W US 36.

NOW THEREFORE, the parties, in consideration of the mutual promises set out in this Agreement, the receipt and sufficiency of which is hereby acknowledged, agree as follows:

1. The Applicant agrees that all workmanship and materials shall conform to all District ordinances and the District's construction standards. District must accept and approve all work and materials before backfilling and final connection is made to the sewer mains. Any violation of this provision will cause all lines and appurtenances in violation to be removed and replaced at the Applicant's expense.
2. The District shall have the right to enter upon the Applicant's premises at all reasonable times to inspect, repair, or replace any equipment used in connection with the District's service or which has an impact on said service.
3. The Applicant shall be responsible for all monthly user rates, capacity charges, and tap fees. The failure to pay any rate charge or fee may result in a lien against the property and/or the termination of service to the property, the cost of which will be borne by Applicant, including, but not limited to, all attorney's fees and collection costs.
4. The District shall not be responsible for any damages as a result of any failure to supply service unless said damages are due to default, neglect or culpability on the part of the District.
5. If there is an available sanitary sewer within three hundred (300) feet of the property line, the property owner shall be required to connect to the District's sanitary sewer system.
6. The Applicant and District agree that the provision of sanitary sewer service touches and concerns the property and the terms of this Agreement bind the District and Applicant and their heirs, executors, administrators, personal representatives, successors, agents, attorneys, assigns, designees, and transferees.

The parties hereto have read and fully understand the above provisions and agree to comply with said provisions.

FALL CREEK REGIONAL WASTE DISTRICT
Deborah L. Wilson
 Signature

APPLICANT

Signature

STATE OF INDIANA)
) SS:
 COUNTY OF MADISON)

SUBSCRIBED and sworn to before me this 24th day of June, 2005.

My Commission Expires:
2-20-2008

Signature

Printed

Notary Public

Resident of Madison County

 INSPECTOR Don DATE INSPECTED 9-29-05 APPROVED X REJECTED _____

REASON FOR REJECTION _____

DATE REINSPECTED _____ APPROVED _____ REJECTED _____

NOTES:
 SIZE PIPE 1 1/2 TYPE PIPE 160

BASEMENT YES NO X

SUMP PUMP YES NO

DOWNSPOUT TO GROUND YES X NO


SEPTIC TANK PUMPED & FILLED YES NO

CONTRACTOR Red Bud Homes

SPECIAL CONDITIONS _____

EXISTING HOME _____

NEW CONSTRUCTION X

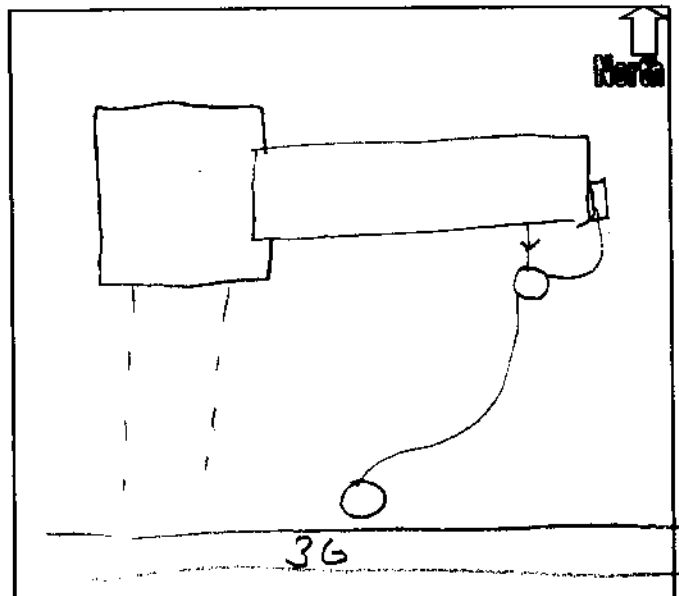

Vendor No: FALC01/Name: Fall Creek Regional Waste District

44335

Invoice	Reference	Inv Date	Inv Amt	Amt Paid	Discount	Adj Amt	Net Amt
WILHOITE		06/23/05	4184.72	4184.72	0.00	0.00	4184.72

(Acct: 10200-)

Check Date = 06/23/05

Total = ***4,184.72



REDBUD ESTATES SALES, INC.
1800 WEST 38TH STREET
ANDERSON, INDIANA 46013

STAR FINANCIAL BANK
735 MAIN STREET
ANDERSON, INDIANA 46015
71-167749

44335

***Four Thousand One Hundred Eighty-Four & 72/100 Dollars

DATE

AMOUNT

06/23/05

***4,184.72

PAY
TO THE
ORDER
OF

Fall Creek Regional Waste District
P.O. Box 59, Co. Rd. 650 West
Pendleton, IN 46064

⑈044335⑈ ⑈074901672⑈